


Section 8 Township 20 Range 9 W

Well No. # 5 Coldwater "A"

Company Cities Service

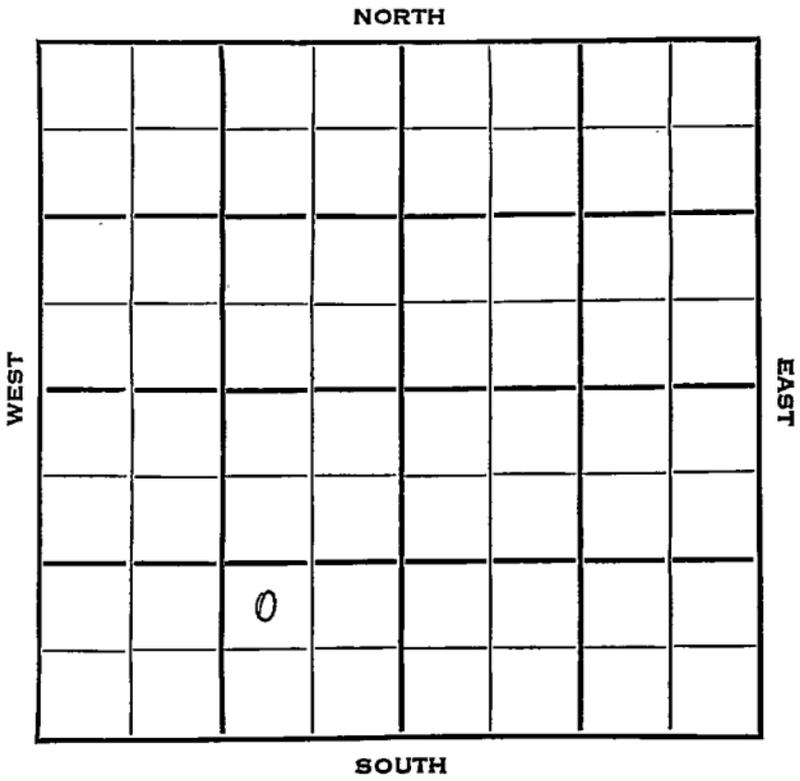

Rice

KANSAS

SEC. 8	TWP. 20	R. 9W
-----------	------------	----------

WELL NO. #5 Goldwater "A" FARM

COMPANY

Cities Service

CONTRACTOR Barbour Drlg.


Chase-Silica Pool NORTH

_____ Ft. from N. Line

990 _____ Ft. from S. Line

990 _____ Ft. from E. Line

_____ Ft. from W. Line

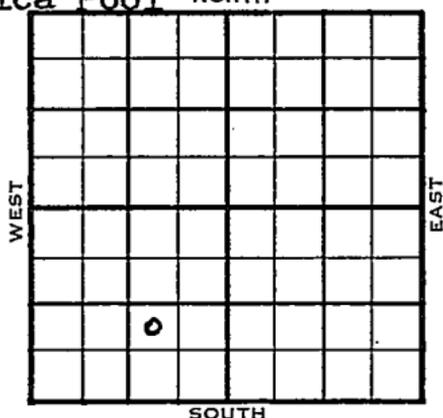

NW SE SW

	ELEVATION	REPORT
1953	1744'	

11/30

Location

12/9

8" @ 225' w/175 sks

12/16

Arb. 3254'
TD 3261'

12/30

Spud 12-5-53 Oil well TD 3262
 8" @ 225 Br. lime 2914 Lans. 2944
 DST 3255-61 open 1 hr rec 50' oil,
 115' MCO 660# Arb. 3254 TD 3261
 5" @ 3255 DD 3262 P/54 BO
 123 BW Comp. 54 BOPD 123 BW

COMPLETED

