

Section 8 Township 20 Range 2WWell No. #1 KoehnCompany Musgrove Pet.

NORTH

SOUTH

WEST

EAST

12

0

McPherson KANSAS

SEC.	TWP.	R.
8	20	2W ✓

WELL NO.

1 Koehn

FARM

COMPANY

Musgrove Petr.

CONTRACTOR

Musgrove

Wildcat

_____ Ft. from N. Line

990


_____ Ft. from S. Line

330

_____ Ft. from E. Line

_____ Ft. from W. Line

NE SE SE

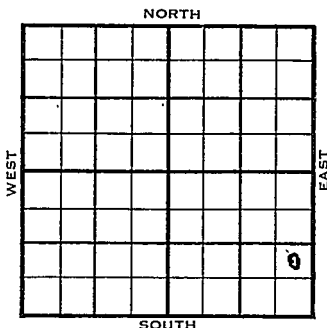

1954

ELEVATION
1492'

REPORT

3/3

Spud 3-1-54
8" @ 158', WOC

3/10

Drlg. 2839'

3/17

Spud 3-1-54
D & A

TD 3005'

8" @ 158'


Lans 2314', Ero Miss 2974' Miss 2988'

TD 3005'

D & A

ABANDONED

County McPherson State Kansas
 Sec. 8 (Blk. 20) (Sur. 2W) (Rge.) Map No.
 Operator Musgrove Pet.
 Well No. 1 Farm Koehn
 Elev. 1492 Location NE SE SE

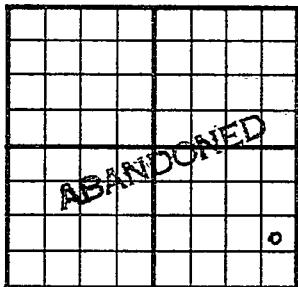

990 Ft. From S Line SE
330 Ft. From E Line Quarter
 Ist. Report
 Completion MAR 17 1954
 Remarks Wildcat
Musgrove - Contr.
 Spudding Date 3-1-54

Drilg. Data D & A TD 3005
8" @ 158 Lans. 2314 EroMiss. 2974
Miss. 2988 TD 3005
D & A