

KANSAS

Form 51-5M-7-40-Palace

McPherson


Section 8 Township 20 Range 1-W

Well No. #1 Vogts

Company Kiowa & Comanche

NORTH

Ritz Canton Pool

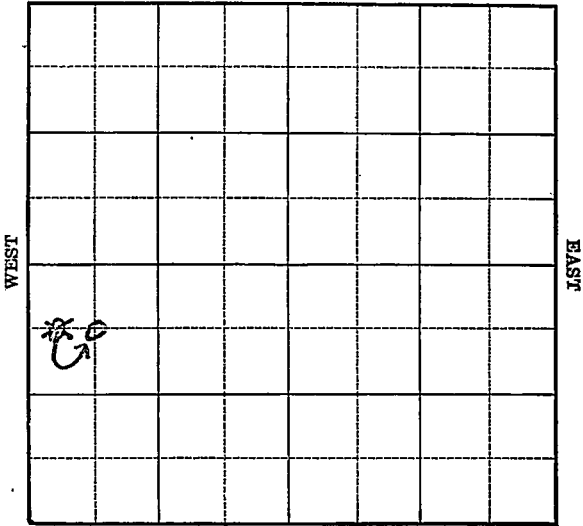


SOUTH

Sec. 8 Twp. 20 R. 1-WWell No. #1 Vogts FarmKiowa & Comanche Company

(Ritz Canton)

660 Ft. from N. Line Ft. from S. Line Ft. from E. Line660~~330~~ Ft. from W. Line

Elev. 1578

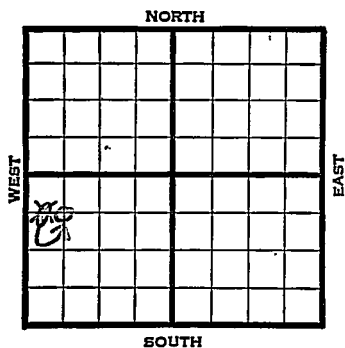

1940

REPORT

12/18

Location

12/26

Derrick.

1941

1/2

"

1/9

8" = 130' Drlg. 1470'

1/16

Lans. 2370' Drlg. 2374'

1/22

Miss. 3010'

T.D. 3012'

No shows.

ABANDONED


Map No. 43 Sec. 8 Twp. 20 R. 1WWell No. 1 VogtsKiowa & Comanche CompanyFIRST REPORT Contractor

C W L NW SW

660 Ft. from N. Line Ft. from S. Line Ft. from E. Line330 Ft. from W. Line

Ritz Canton Pool

SECTION PLAT

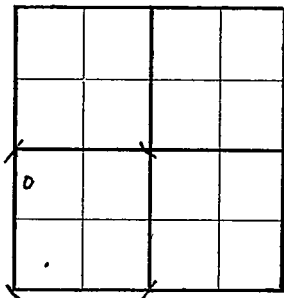Location XRig up

Drilling and Remarks:

RECORD

Cased in., ft.Sand Gas Oil Total Depth

PRODUCTION

1st 24 hrs. Nat. 1st 24 hrs. after shot Gas Cu. Ft.Dry Hole Abandoned

Date

DEC 18 1940

19

S. J. LEWIS Scout

Map No. 43 Sec. 8 Twp. 20 R. 1WWell No. 1 VogtsKiowa & Comanche CompanyCORRECTION Contractor**SECTION PLAT**

o			

C NW SW

660 Ft. from N. Line Ft. from S. Line Ft. from E. Line660 Ft. from W. Line

RITZ CANTON POOL

Location Rig up

Drilling and Remarks:

Reported

C W L NW SW

RECORDCased in., ft.Sand Gas Oil Total Depth **PRODUCTION**1st 24 hrs. Nat. 1st 24 hrs. after shot Gas Cu. Ft.Dry Hole Abandoned

Date

JAN 8 1941 19 S. J. LEWIS Scout

Map No. 43 Sec. 8 Twp. 20 R. 1WWell No. 1 VogtsKiowa & Commanche Company

Contractor

ABANDONED

C NW SW

660 Ft. from N. Line Ft. from S. Line Ft. from E. Line660 Ft. from W. Line

RITZ GANTON POOL

SECTION PLAT

o			

Location Rig up

Drilling and Remarks:

Wells 2010
No shows

RECORDCased in., ft.Sand Gas Oil Total Depth 2012**PRODUCTION**1st 24 hrs. Nat. 1st 24 hrs. after shot Gas Cu. Ft.Dry Hole Abandoned

Date

JAN 22 1941 19 S. J. LEWIS Scout