


Mc Pherson

Form 51-5M-11-31-Police

Map No. KANSAS Sec. 8 Twp. 20 R. 1 W

Well No. 2 Vogte Farm
Regina Oil & Gas Company

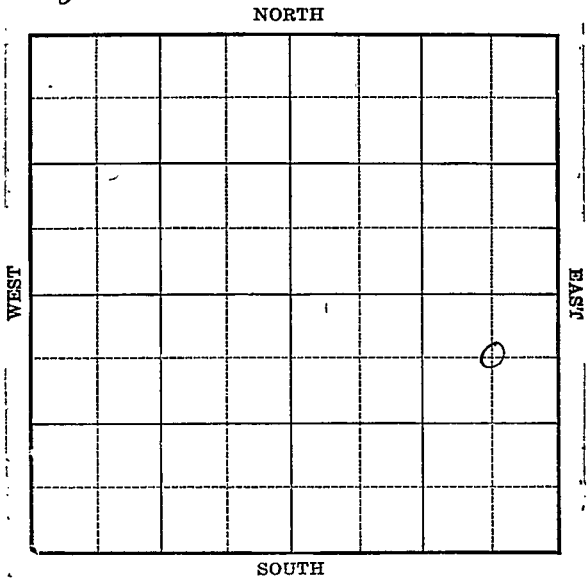

Location _____
Drilling Remarks _____

Rig Up _____
Drilling Remarks _____

RECORD

Cased _____ in. _____ ft.
Sand _____
Gas _____
Oil _____
Total Depth _____

PRODUCTION

1st 24 hrs. Nat. _____
1st 24 hrs. after shot _____
Gas _____ cu. ft. _____
Dry Hole _____
Abandoned _____

McPherson


Map No. KANSAS Sec. 8 Twp 20 R. 1W
Well No. #1A Vogts Farm
Regina Oil-Gas Company

660 Ft. from N. Line

_____ Ft. from S. Line

660 Ft. from E. Line

_____ Ft. from W. Line

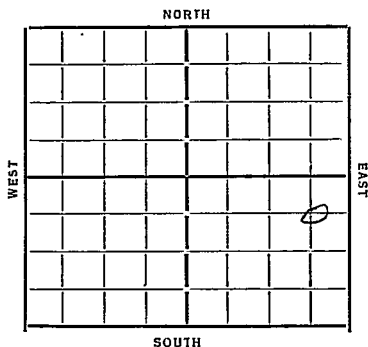

Date 1934

REPORT

1/24 Cellar
1/31 Building Rig
2/7 — 2/14
2/23 R U
3/1 15" at 147 GOC
3/8 Only 1423
3/15 " 2545 GOC 2325
3/22 " 3028 Chat 2920
3/29 Viola 3392 6" 3392 Rust
4/5 Bailing
4/12 TD 3414 1500' oil 1000
4/12 Hel acid G.O. A
4/19 TD 3414 Pump 33 oil
4/19 97 water 2 hrs.
4/26 —
5/2 Viola 3392 TD 3414
5/2 1000 acid 294 oil 954 water

COMPLETED

Thompson
 Map No. 43 Sec. 8 Twp. 20 R. 1W
 Well No. 2- Vogts
Regina Oil & Gas Company
 Contractor

SECTION PLAT

660 **FIRST REPORTS**
 Ft. from N. Line

Ft. from S. Line

660 Ft. from E. Line

Ft. from W. Line

			0

Location.....

Rig up.....

Drilling and Remarks:

clean

RECORD

Cased.....in.,ft.

Sand.....

Gas.....

Oil.....

Total Depth.....

PRODUCTION

1st 24 hrs. Nat.....

1st 24 hrs. after shot.....

Gas.....Cu. Ft.

Dry Hole.....

Abandoned.....

Date

1-24-34 192 O. Mannhuber Scout

Map No. 43 Sec. 8 Twp. 20 R. 1WWell No. 1A - VogtsRegina CompanyCORRECTION ContractorCORRECTION

SECTION PLAT

			0

660 Ft. from N. Line660 Ft. from S. Line660 Ft. from E. Line660 Ft. from W. LineCORRECTIONLocation formerly reportedRig up as #2

Drilling and Remarks:

RECORD

Cased in., ft.Sand ft.Gas ft.Oil ft.Total Depth ft.

PRODUCTION

1st 24 hrs. Nat. ft.1st 24 hrs. after shot ft.Gas Cu. Ft.Dry Hole ft.Abandoned ft.

Date

2-7-34 192 W. Mansscheck Scout

KANSAS

Map No. 43 Sec. 8 Twp. 20 R. 1WWell No. 1A-VogtsRegina Oil Company

Contractor

COMPLETED

SECTION PLAT

660 Ft. from N. Line Ft. from S. Line660 Ft. from E. Line Ft. from W. Line

			0

Location Rig up

Drilling and Remarks:

1000 acid294 oil
954 water

RECORD

Cased in., ft.Sand Viola 3392Gas Oil Total Depth 3414

PRODUCTION

1st 24 hrs. Nat. 1st 24 hrs. after shot Gas Cu. Ft.Dry Hole Abandoned

Date

5-2-34 19

GEORGE W. MANISCHRECK

Scout