

Map No. **KANSAS** Sec. 9 Twp. 20 R. 9W *Rice*  
 Well No. 15 Dewitt Farm \_\_\_\_\_  
Gypsy oil Company \_\_\_\_\_

NORTH

WEST

EAST

SOUTH

Location \_\_\_\_\_

Drilling Remarks \_\_\_\_\_

Rig Up \_\_\_\_\_

Drilling Remarks \_\_\_\_\_

## RECORD

Cased \_\_\_\_\_ in. \_\_\_\_\_ ft.

Sand \_\_\_\_\_

Gas \_\_\_\_\_

Oil \_\_\_\_\_

Total Depth \_\_\_\_\_

## PRODUCTION

1st 24 hrs. Nat. \_\_\_\_\_

1st 24 hrs. after shot \_\_\_\_\_

Gas \_\_\_\_\_ cu. ft. \_\_\_\_\_

Dry Hole \_\_\_\_\_

Abandoned \_\_\_\_\_

Map No. KANSAS Sec. 9 Twp. 20 R. 9<sup>W</sup> *Rice*  
Well No. 1- Dewitt Farm  
Gypsy Oil Company


         Ft. from N. Line

330 Ft. from S. Line

330 Ft. from E. Line

         Ft. from W. Line

Elev. 1716

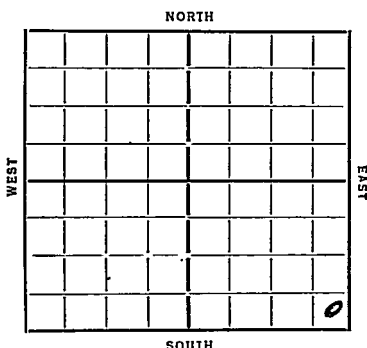

| Date | REPORT             |
|------|--------------------|
| 6/19 | Cellar             |
| 6/28 | R 2                |
| 7/3  | Qty 250 10" 192    |
| 7/11 | " 2505             |
| 7/18 | Sib 3226 T 2 3227  |
|      | 698 3226 Rust      |
| 8/7  | Top Siliceous 3230 |
|      | T.D. 3250          |
|      | 1000 acid          |
|      | 1101 bbls oil      |
|      | COMPLETED          |

Map No. 49 Sec. 9 Twp. 20 R. 9w

Well No. 1-De Witt

Gypsy oil Company

Contractor

FIRST REPORTS

Ft. from N. Line

330 Ft. from S. Line

330 Ft. from E. Line

Ft. from W. Line

SECTION PLAT

|  |  |  |  |
|--|--|--|--|
|  |  |  |  |
|  |  |  |  |
|  |  |  |  |
|  |  |  |  |
|  |  |  |  |

Location

Rig up

Drilling and Remarks:

clean

RECORD

Cased in., ft.

Sand

Gas

Oil

Total Depth

PRODUCTION

1st 24 hrs. Nat.

1st 24 hrs. after shot

Gas Cu. Ft.

Dry Hole

Abandoned

Date

6-19-35

192

ORVAL MANNSCHRECK

Scout

Map No. 49 Sec. 9 Twp. 20 R. 9W

Well No. 1-Dewitt

Hydro oil Company

Contractor

COMPLETED

SECTION PLAT

|  |  |  |   |
|--|--|--|---|
|  |  |  |   |
|  |  |  |   |
|  |  |  |   |
|  |  |  |   |
|  |  |  | 0 |

Ft. from N. Line

330 Ft. from S. Line

330 Ft. from E. Line

Ft. from W. Line

Location

Rig up

Drilling and Remarks:

1000 and

1101 bbls  
oil

RECORD

Cased in. ft.

Sand oil 3230

Gas

Oil

Total Depth 3250

PRODUCTION

1st 24 hrs. Nat.

1st 24 hrs. after shot

Gas Cu. Ft.

Dry Hole

Abandoned

Date

8-7-35 192

ORVAL MANN SCHRECK

Scout