

KANSAS

Rice


FORM 51 5M 1-42 PETROL

Section 9 Township 20 Range 9-W

Well No. #1 Dick

Company Cities Service Oil

NORTH Keesling Pool

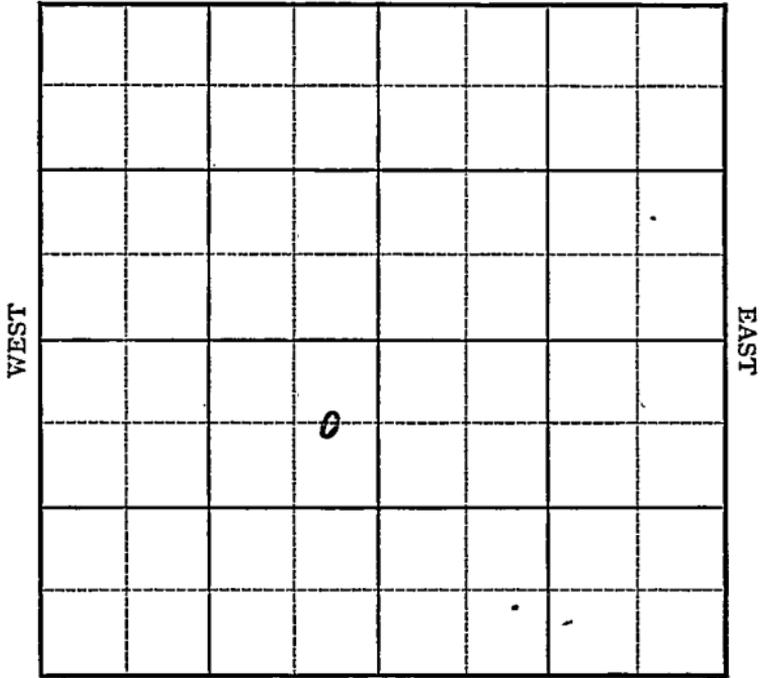

SOUTH

Sec 9 Twp. 20 R. 9-W

Well No. #1 Dick Farm _____

Cities Service Oil Company _____

(Keesling)


660 Ft. from N. Line

_____ Ft. from S. Line

330 Ft. from E. Line

_____ Ft. from W. Line

Elev. 1729

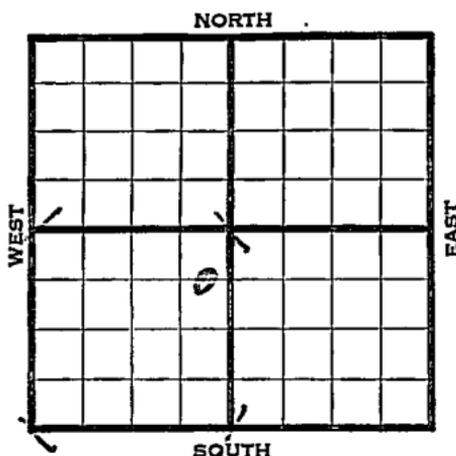

| 1942 | REPORT |
|------|---|
| 4/8 | 8" - 255' WOC. |
| 4/15 | Drlg. 3051' |
| 4/22 | Arb. 3240-45' ³²³⁸ T.D. S.S.O. 5" - 3243' ^{3241'} RUST. |
| 4/29 | Arb. 3238' (Corrected) 5" - 3241' T.D. 3256' 2050 acid. Swab 76 oil in 8 hours. |
| 5/6 | Arb. 3238' 5" - 3241' T.D. 3256' Shot 10 qts. 3246-56' 4050 acid. Potential 300 bbls., pump. 44.5 Gravity |
| | COMPLETED |

Rice

KANSAS

Map No. 49 Sec. 9 Twp. 20 R. 9WWell No. 1 DickCities Service Oil CompanyFIRST REPORT Contractor

C E L N E S W


SECTION PLAT

660 Ft. from N. Line

_____ Ft. from S. Line

330 Ft. from E. Line

_____ Ft. from W. Line

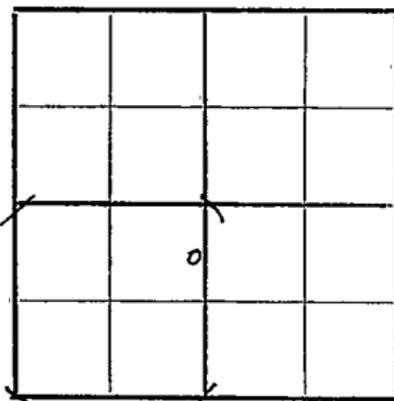

KEESLING POOL

Location _____

Rig up _____

Drilling and Remarks:

8" - 255'Waiting oncement to set

RECORD

Cased _____ in., _____ ft.

Sand _____

Gas _____

Oil _____

Total Depth _____

PRODUCTION

1st 24 hrs. Nat. _____

1st 24 hrs. after shot _____

Gas _____ Cu. Ft.

Dry Hole _____

Abandoned _____

Date

APR 8 1942 19G. J. LEWIS Scout

