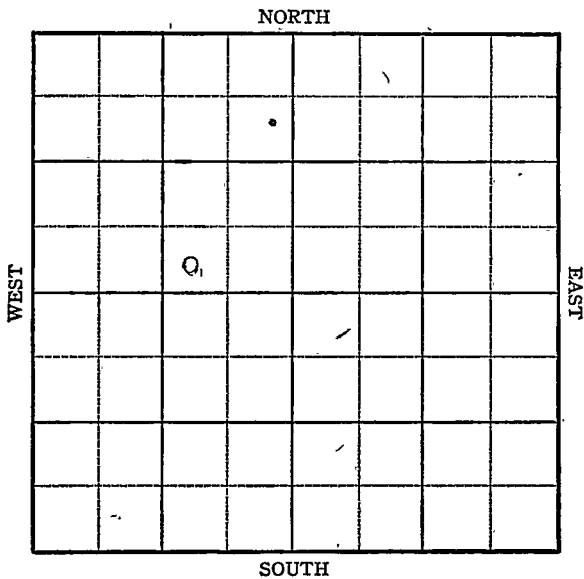


KANSAS

Rice

FORM 51 5M PETROL

Section 9 Township 20 Range 9WWell No. 1 Proffitt "B"Company Bay Pet.

KANSAS Rice.

Sec. 9 Twp. 20 R. 9-W

Well No. #1 Proffitt "B" Farm


Bay Pet. Company

 Ft. from N. Line

330 Ft. from S. Line

990 Ft. from E. Line

 Ft. from W. Line

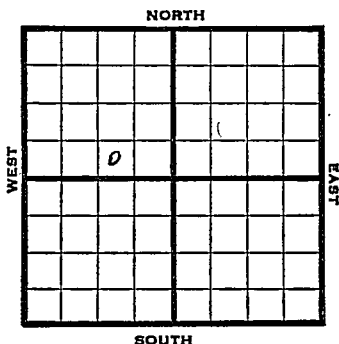

SW SE NW Elev. 1725

1945 REPORT

9/19	8" @ 158'
	Drlg. 805'
9/26	Drlg. 2300'
10/3	Lans 2916
	Arb. 3228
	TD 3235
	5" @ 3230 RUST
10/10	" " "
10/17	TD 3241 9 qts. 500 acid.
10/24	TD 3243 $\frac{1}{2}$ swb. 12 oil per hr.
10/31	" " " " "
11/7	" " " " "
11/14	" " " " "
11/21	" " " " "
11/28	" " " " "
12/5	Arb. 3228
	5" @ 3230
	500 acid.
	TD 3243 $\frac{1}{2}$
	Pump 100 Pot.
	Grav. 41.7

COMPLETED

KANSAS

Kansas Pool Name SilicaMap No. 49 Sec. 9 Twp. 20 R. 9WWell No. 1 Proffitt "B"


Bay Pet. _____ Company _____

FIRST REPORT

Contractor _____

SW SE NW

SECTION PLAT

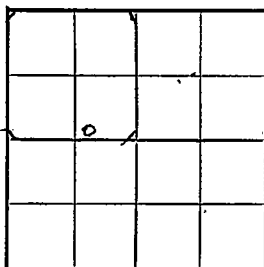

_____ Ft. from N. Line

330 Ft. from S. Line990 Ft. from E. Line

_____ Ft. from W. Line

Rice County

Location _____

Rig up _____

Drilling and Remarks:

8"-158

805

RECORD

Cased _____ in., _____ ft.

Sand _____

Gas _____

Oil _____

Total Depth _____

PRODUCTION

1st 24 hrs. Nat. _____

1st 24 hrs. after shot _____

Gas _____ Cu. Ft.

Dry Hole _____

Abandoned _____

Date

SEP 1 9 1945

19

S. J. LEWIS

Scout

KANSAS


Kansas Pool Name SilicaMap No. K29 Sec. 9 Twp. 20 R. 9WWell No. 1 Proffitt "B"

Bay Pet. _____ Company _____

COMPLETED

Contractor _____

SW SE NW

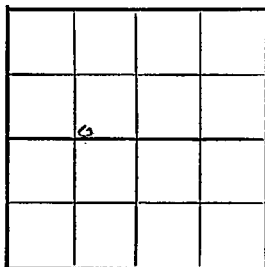E. 1/2
SECTION PLAT

_____ Ft. from N. Line

330 Ft. from S. Line990 Ft. from E. Line

_____ Ft. from W. Line

Rice County

Location _____

Rig up _____

Drilling and Remarks:

Per 8225
5' 03230
500 acid
Pump 100 lbs

41 2 42

RECORD

Cased _____ in., _____ ft.

Sand _____

Gas _____

Oil _____

Total Depth 3248 1/2

PRODUCTION

1st 24 hrs. Nat. _____

1st 24 hrs. after shot _____

Gas _____ Cu. Ft.

Dry Hole _____

Abandoned _____

Date

DEC 5 1945

19

S. J. LEWIS

Scout