

KANSAS

FORM 51 5M 10-41 PETROL


Rice

Section 9 Township 20 Range 9-W

Well No. #2 Dick "A"

Company Cities Service Oil

Chase Pool

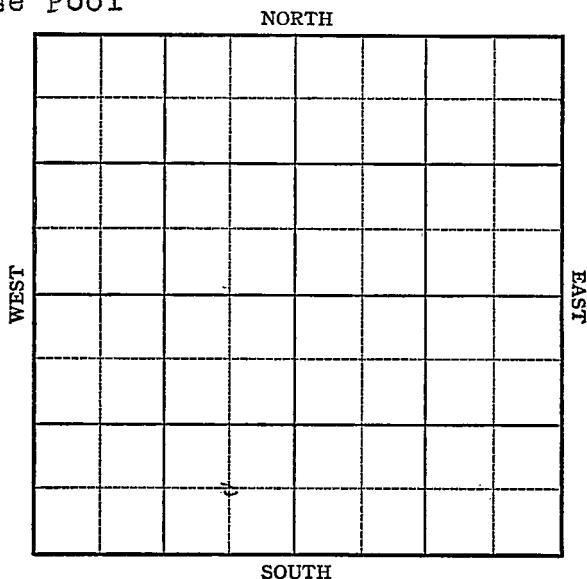

KANSAS Rice

Sec. 9 Twp. 20 R. 9-W

Well No. #2 Dick "A" Farm

Cities Service Oil Company

(Chase Pool)


 Ft. from N. Line

660 Ft. from S. Line

660 Ft. from E. Line

 Ft. from W. Line

Elev. 1732

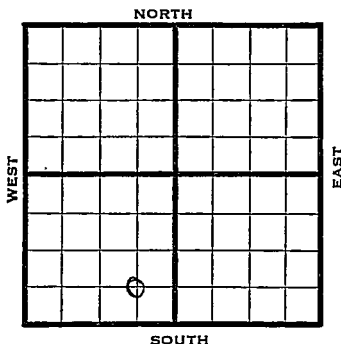

1942

REPORT

9/9

Location

9/16

Rotary

9/23

10" @ 123 Drlg 2145

9/30

TD 3247 WOC. 7" - 3244

Arb. ~~3240~~ 3238'

10/7

Arb. 3238 (Corrected)

7" - 3242 T.D. 3255-600 oil
1500 acid.

10/14

Arb. 3238

7" - 3242

1500 acid

Pump 530 Pot.

Gravity 44.7

T.D. 3255'

COMPLETED

KANSAS

Rice

Map No. 49 Sec. 9 Twp. 20 R. 9WWell No. 2 Dick "A"Cities Service Oil CompanyFIRST REPORT Contractor

C SE SW

SECTION PLAT

 Ft. from N. Line660 Ft. from S. Line660 Ft. from E. Line Ft. from W. Line

	0		

CHASE POOL

Location XXXRig up

Drilling and Remarks:

RECORD

Cased in., ft.Sand Gas Oil Total Depth

PRODUCTION

1st 24 hrs. Nat. 1st 24 hrs. after shot Gas Cu. Ft.Dry Hole Abandoned

Date

SEP 9 1942 19 S. J. LEWIS Scout

Map No. 49 Sec. 9 Twp. 20 R. 9WWell No. 2 Dick "A"Cities Service Oil CompanyCOMPLETED Contractor

C SE SW

SECTION PLAT

 Ft. from N. Line660 Ft. from S. Line .660 Ft. from E. Line Ft. from W. Line

	o		

CHASE POOL

Location Rig up

Drilling and Remarks:

Cor 83238
7" 83242
1500 acid
Pump 530 P.S.
442 Gr

RECORD

Cased in., ft.Sand Gas Oil Total Depth 8253

PRODUCTION

1st 24 hrs. Nat. 1st 24 hrs. after shot 34Gas Cu. Ft.Dry Hole Abandoned

Date

OCT 14 1942 19 S. L. LEWIS Scout