

FORM 51 5M 4-41 PETROL


Rice

Section 9 Township 20 Range 9-W

Well No. #2 Cox

Company R. Olsen Oil

NORTH Keesling Pool

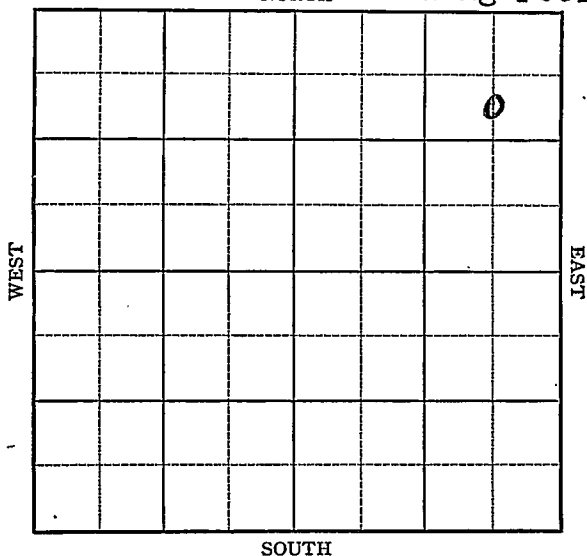

Map No. 49 Sec. 9 Twp. 20 R. 9WWell No. 2 Cox

R. Olsen Oil


Company

FIRST REPORT

Contractor

SECTION PLAT

C S L NE NE

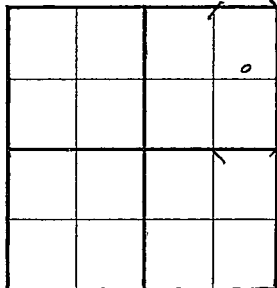990 Ft. from N. Line Ft. from S. Line660 Ft. from E. Line Ft. from W. Line

KEESLING POOL

Location XRig up

Drilling and Remarks:

RECORD

Cased in., ft.Sand Gas Oil Total Depth

PRODUCTION

1st 24 hrs. Nat. 1st 24 hrs. after shot Gas Cu. Ft.Dry Hole Abandoned

Date

APR 9 1941

19

S. J. LEWIS

Scout

Map No. 49 Sec. 9 Twp. 20 R. 9WWell No. 2 CoxR. Olson Oil

Company

~~COMPLETED~~

Contractor

SECTION PLAT

C S L NE NE

990 Ft. from N. Line Ft. from S. Line660 Ft. from E. Line Ft. from W. Line

			<u>a</u>
<u>1</u>			

KEESLING POOL

Location Rig up

Drilling and Remarks:

*Cr 83210**5" @ 3212**Pump 496**43-5-82*

RECORD

Cased in., ft.Sand Gas Oil Total Depth 3227

PRODUCTION

1st 24 hrs. Nat. 1st 24 hrs. after shot Gas Cu. Ft.Dry Hole Abandoned

Date

MAY 14 1941 19S. J. LEWIS Scout