


Map No. **KANSAS** Sec. **9** Twp. **20** R. **Rice 9W**
Well No. **2- All With Gypsy Oil** Farm _____ Company _____

NORTH

WEST

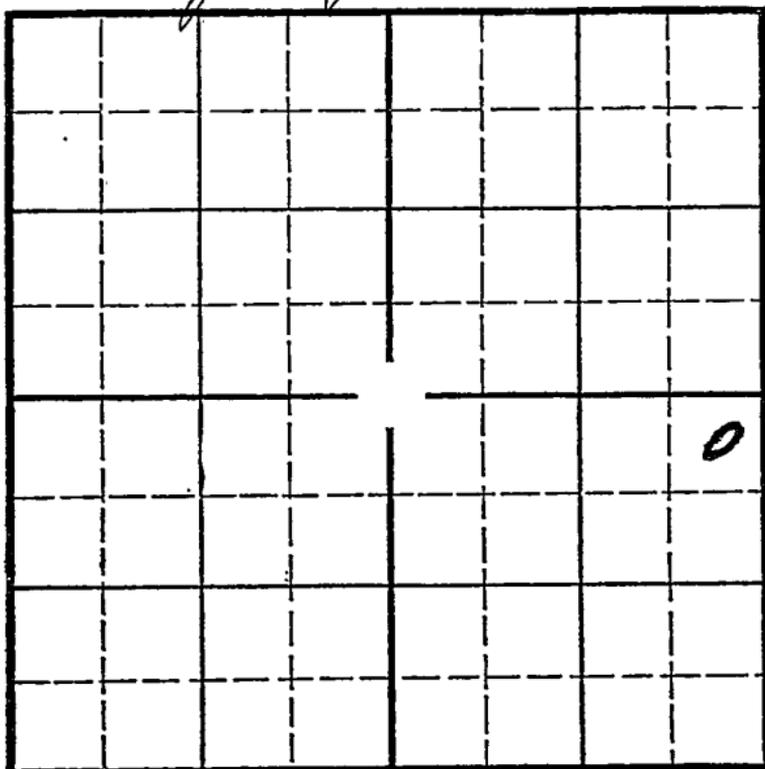

EAST

SOUTH

Location _____
Drilling Remarks _____

Rig Up _____
Drilling Remarks _____

RECORD

PRODUCTION

Cased _____ in. _____ ft.
Sand _____
Gas _____
Oil _____
Total Depth _____

1st 24 hrs. Nat. _____
1st 24 hrs. after shot _____
Gas _____ cu. ft. _____
Dry Hole _____
Abandoned _____

Rice

Map No. KANSAS Sec. 9 Twp. 20 R. 9W

Well No. 2 De Witt Farm



330 Ft. from N. Line

_____ Ft. from S. Line

330 Ft. from E. Line

_____ Ft. from W. Line

Elev. 1722

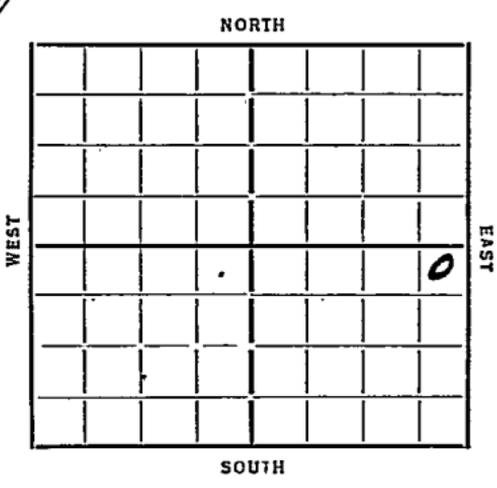

Date	REPORT
6/26	Cellar
7/3	Rgn
7/11	Blg 1130
7/18	" 3210
7/19	T Siliceous lime 3237
	Rust (2l)
8/7	Top siliceous 3237
	T.D. 3288
	P.B. to 3271 40 gts
	1000 gallons acid
	560 oil
	2 water
	COMPLETED

Map No. 49 Sec. 9 Twp. 20 R. 9W

Well No. 2 The Witt


Contractor

SECTION PLAT

			0

330 Ft. from N. Line

..... Ft. from S. Line

330 Ft. from E. Line

..... Ft. from W. Line

FIRST REPORTS

Location.....

Rig up.....

Drilling and Remarks:

Cellar

RECORD

Cased..... in., ft.

Sand.....

Gas.....

Oil.....

Total Depth.....

PRODUCTION

1st 24 hrs. Nat.....

1st 24 hrs. after shot.....

Gas..... Cu. Ft.

Dry Hole.....

Abandoned.....



Date

7/26/35 192.....

ORVAL MANNSCHRECK


Scout

Map No. 49 Sec. 9 Twp. 20 R. 9W

Well No. 2-Dewitt

Gypsy oil Company

Contractor

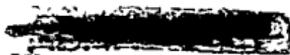

SECTION PLAT

			27
			0

330 Ft. from N. Line

Ft. from S. Line

330 Ft. from E. Line

Ft. from W. Line

1000 and

Location.....

Rig up.....

Drilling and Remarks:

*PB 3271
40 gts.
1000 and*

*560 oil
2 Water*

RECORD

Cased..... in. ft.

Sand *oil 3237*

Gas.....

Oil.....

Total Depth 3288

PRODUCTION

1st 24 hrs. Nat.....

1st 24 hrs. after shot.....

Gas..... Cu. Ft.

Dry Hole.....

Abandoned.....

Date

8-7-35 192

ORVAL MANNSCHRECK

Scout