

KANSAS

Form 51-5M-7-40-Palace


Rice

Section 9 Township 20 Range 9-W

Well No. #1 Cox

Company R. Olson Oil

NORTH Keesling Pool

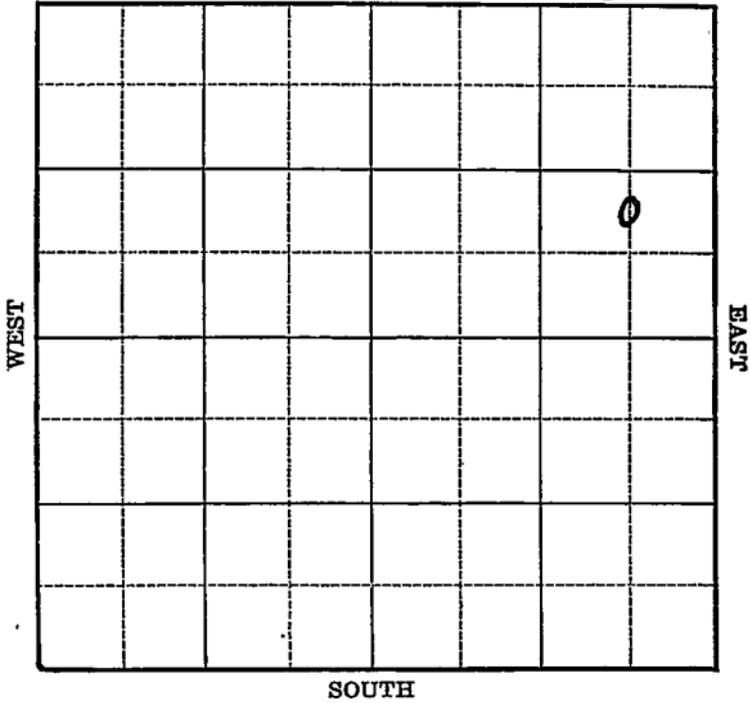

Sec. 9 Twp. 20 R. 9-W

Well No. #1 Cox Farm

R. Olson Oil Company

(Keesling)


 Ft. from N. Line

990 Ft. from S. Line

66.0 Ft. from E. Line

 Ft. from W. Line

Elev. 1713

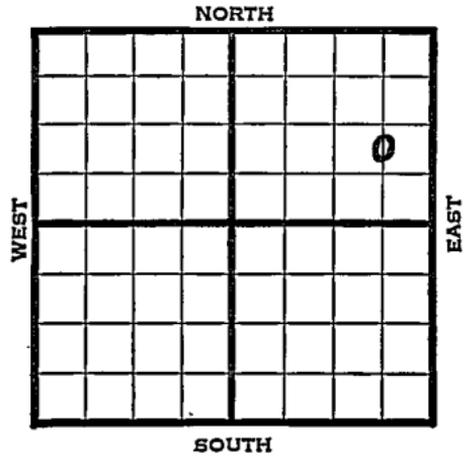

1941

REPORT

3/19

S. H.

3/27

8" - 212' Drlg. 2610'

4/3

Arb. 3217' 5" - 3218'

T.D. 3220' RUST.

4/10

T.D. 3245' 1000 acid.

Pump 15 bbls. per hour 3 hours.

4/16

Arb. 3217'

T.D. 3245'

1000 acid.

Pump 162 bbls.

43.8 Gravity

COMPLETED

Map No. 49 Sec. 9 Twp. 20 R. 9WWell No. 1 CoxR. Olson Oil Company**FIRST REPORT** Contractor

SECTION PLAT

C N L S E N E

 Ft. from N. Line990 Ft. from S. Line660 Ft. from E. Line Ft. from W. Line

KEESLING POOL

			o

Location _____

Rig up _____

Drilling and Remarks:

S. H.

RECORD

Cased _____ in., _____ ft.

Sand _____

Gas _____

Oil _____

Total Depth _____

PRODUCTION

1st 24 hrs. Nat. _____

1st 24 hrs. after shot _____

Gas _____ Cu. Ft.

Dry Hole _____

Abandoned _____

Date

MAR 19 1941

19

S. J. LEWIS Scout

