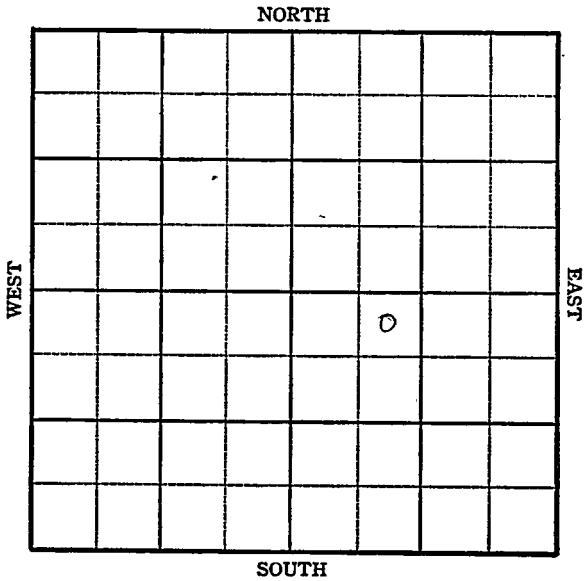


KANSAS.

Rice

FORM 51 5M PETROL

Section 9 Township 20 Range 9WWell No. 3 DeWittCompany Bay Pet.

KANSAS

Rice

Sec. 9 Twp. 20 R. 9-W

Well No. #3 DeWitt Farm


Bay Pet. Company

330 Ft. from N. Line

 Ft. from S. Line

 Ft. from E. Line

990 Ft. from W. Line

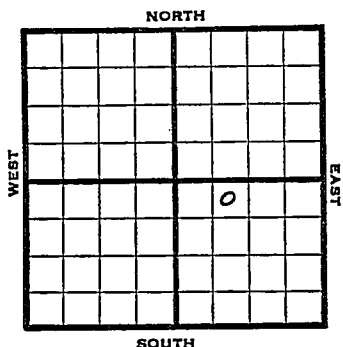

NE NW SE

1945 Elev. 1723 REPORT

10/24	Location
10/31	8" @ 164
	Drlg. 1530
11/7	Drlg. 2970'
11/14	Arb. 3236
	TD 3239
	5" @ 3238 RUST
11/21	" " "
11/28	" " "
12/5	500 acid.
	Swb. 5 oil per hr.
12/12	" " "
12/20	" " "
12/28	Arb. 3236
	5" @ 3238
	500 acid.
	TD 3247
	Pump 100 Pot.
	Grav. 42.0

COMPLETED

KANSASKansas Pool Name SilicaMap No. 49 Sec. 9 Twp. 20 R. 9WWell No. 3 DeWitt

Bay Pat. _____ Company _____

FIRST REPORT Contractor _____

NE NW SE

SECTION PLAT330 Ft. from N. Line

_____ Ft. from S. Line

_____ Ft. from E. Line

990 Ft. from W. Line

Rice County

Location X

Rig up _____

Drilling and Remarks:

RECORD

Cased _____ in., _____ ft.

Sand _____

Gas _____

Oil _____

Total Depth _____

PRODUCTION

1st 24 hrs. Nat. _____

1st 24 hrs. after shot _____

Gas _____ Cu. Ft.

Dry Hole _____

Abandoned _____

Date


OCT 24 1945 19S. J. LEWIS

Scout

KANSAS

Kansas Pool Name SilicaMap No. K-49 Sec. 9 Twp. 1 20 R. 9WWell No. 3 DeWittBay Pet. CompanyCOMPLETED Contractor

NE NW SE

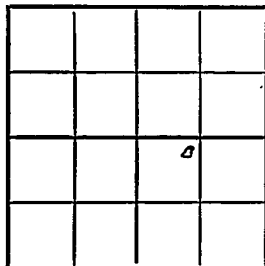E/1723
SECTION PLAT330 Ft. from N. Line Ft. from S. Line Ft. from E. Line990 Ft. from W. LineRice County

Location

Rig up

Drilling and Remarks:

Cer 832365" 83238500 acrilPump 100 Pst42° Gr

RECORD

Cased in., ft.Sand Gas Oil Total Depth 8247

PRODUCTION

1st 24 hrs. Nat. 1st 24 hrs. after shot Gas Cu. Ft.Dry Hole Abandoned

Date

DEC 2 8 1945

19

S. J. LEWIS Scout