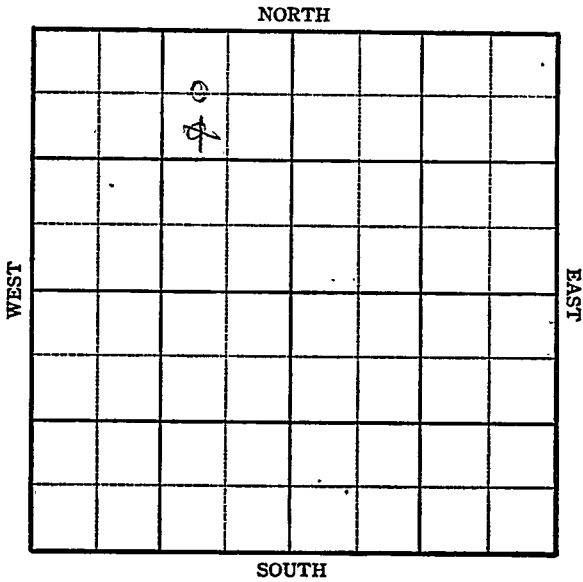


KANSAS

Rice

FORM 51 5M PETROL

Section 9 Township 20 Range 9wWell No. 2 Proffitt "B"Company Bay Pet. C. U. Bay

KANSAS

Rice County

Sec. 9 Twp. 20 R. 9W

Well No. #2 Proffitt "B" Farm

~~Bay Pet.~~ C. U. Bay Company

Silica

~~990~~ 660 Ft. from N. Line


_____ Ft. from S. Line

990 Ft. from E. Line

_____ Ft. from W. Line

~~SW NE NW~~

CWL NE NW

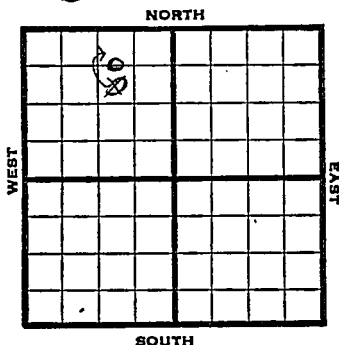

1945

REPORT

Ele v. 1719

10/31 Location

11/7 "

11/14 8" @ 176

Drilg. 1192'

11;21 Drilg. 2768'

11/28 Lans. 2908

Arb. 3223

TD 3225

5" @ 3224

12/5 TD 3243

500 acid.

12/12 TD 3250

12/20 T.D. 3250'

12/28 Arb. 3223

5" @ 3224

500 acid.

TD 3250'

Pump 100 Pot.

Grav. 42.0

COMPLETED

KANSASKansas Pool Name SilicaMap No. 49 Sec. 9 Twp. 20 R. 9WWell No. 2 Proffitt "B"

Bay Pet. _____

Company _____

FIRST REPORT

Contractor _____

SW NE NW

990 Ft. from N. Line

_____ Ft. from S. Line

990 Ft. from E. Line

_____ Ft. from W. Line

Rice County

SECTION PLAT

	o		

Location x

Rig up _____

Drilling and Remarks: _____

RECORD

Cased _____ in., _____ ft.

Sand _____

Gas _____

Oil _____

Total Depth _____

PRODUCTION

1st 24 hrs. Nat. _____

1st 24 hrs. after shot _____

Gas _____ Cu. Ft.

Dry Hole _____

Abandoned _____

Date

OCT 3 1 1945

19

S. J. LEWIS

Scou

KANSAS

Kansas

Pool Name SilicaMap No. 49 Sec. 9 Twp. 20 R. 9WWell No. 2 Proffitt "B"

C U Bay


Company

CORRECTION

Contractor

SW NE NW

SECTION PLAT

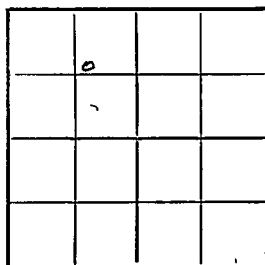990 Ft. from N. Line Ft. from S. Line990 Ft. from E. Line Ft. from W. Line

Rice County

Location Rig up

Drilling and Remarks:

reported as Bay Pat

RECORD

Cased in., ft.Sand Gas Oil Total Depth

PRODUCTION

1st 24 hrs. Nat. 1st 24 hrs. after shot Gas Cu. Ft.Dry Hole Abandoned

Date

NOV 7 1945

19

S. J. LEWIS

Scout

Kansas Pool Name SilicaMap No. 49 Sec. 9 Twp. 20 R. 9WWell No. 2 Proffitt "B"

C. U. Bay

Company

CORRECTION

Contractor

C W L NE NW

SECTION PLAT

	o		

660 Ft. from N. Line Ft. from S. Line990 Ft. from E. Line Ft. from W. Line

Rice County

Location

Rig up

Drilling and Remarks:

Reported

SW NE NW

RECORDCased in., ft.Sand Gas Oil Total Depth **PRODUCTION**1st 24 hrs. Nat. 1st 24 hrs. after shot Gas Cu. Ft.Dry Hole Abandoned

Date

NOV 21 1945 19

S. J. LEWIS

Scout

KANSAS

Kansas

Pool Name SilicaMap No. 11-49 Sec. 9 Twp. 20 R. 9WWell No. 2 Proffitt "B"

C. U. Bay

Company

COMPLETED

Contractor

C W L NE NW

E 1/4 1718
SECTION PLAT660 Ft. from N. Line

Ft. from S. Line

990 Ft. from E. Line

Ft. from W. Line

	0		

Rice County

Location

Rig up

Drilling and Remarks:

Per 32285" @ 3228500 acustPump 100 ft.42 1/2 ft.

RECORD

Cased _____ in., _____ ft.

Sand _____

Gas _____

Oil _____

Total Depth 3250

PRODUCTION

1st 24 hrs. Nat. _____

1st 24 hrs. after shot _____

Gas _____ Cu. Ft.

Dry Hole _____

Abandoned _____

Date

DEC 28 1945 19

S. J. LEWIS

Scout