

KANSAS


Rice

FORM 51 5M PETROL

Section 9 Township 20 Range 9W

Well No. 3 DeWitt

Company C. U. Bay

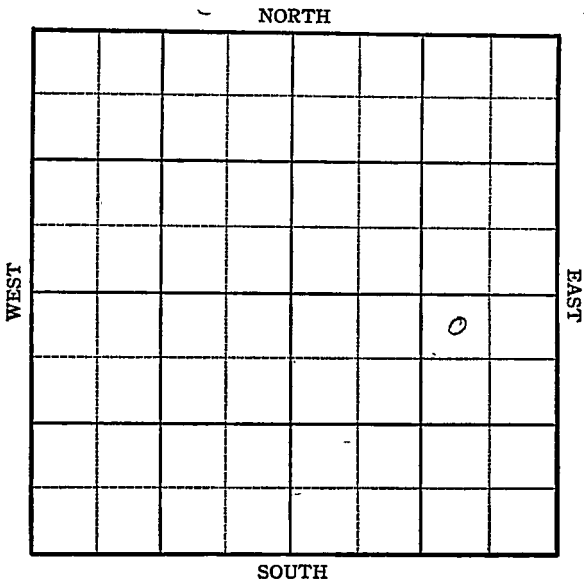

KANSAS Rice

Sec. 9 Twp. 20 R. 9-W

Well No. #3 DeWitt "A" Farm


C. U. Bay Company

330 Ft. from N. Line

_____ Ft. from S. Line

990 Ft. from E. Line

_____ Ft. from W. Line

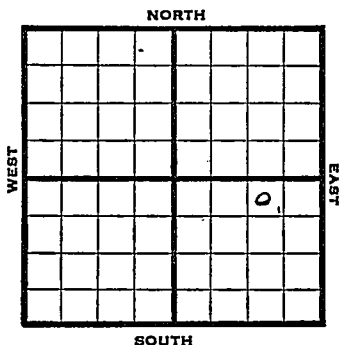

NW NE SE

1945 Elev. 1724 REPORT

11/28 Location

12/5 8" @ 295
Drlg. 2666

12/12 Arb. 3247
TD 3247
5" @ 3247 RUST

12/20 T.D. 3261' 10 gals. oil per hour.

12/28 Arb. 3274
5" @ 3274
TD 3268'
Pump 50 Pot.
Grav. 42.0

COMPLETED

KANSAS Pool Name SilicaMap No. 49 Sec. 9 Twp. 20 R. 9WWell No. 3 DeWitt "A"C. U. Bay CompanyFIRST REPORT Contractor

NW NE SE

SECTION PLAT

330 Ft. from N. Line Ft. from S. Line990 Ft. from E. Line Ft. from W. Line

			o

Rice CountyLocation XRig up

Drilling and Remarks:

RECORD

Cased in., ft.Sand Gas Oil Total Depth

PRODUCTION

1st 24 hrs. Nat. 1st 24 hrs. after shot Gas Cu. Ft.Dry Hole Abandoned

Date

NOV 28 194519S. J. LEWIS

Scout

KANSAS

Kansas Pool Name SilicaMap No. K-49 Sec. 9 Twp. 20 R. 9WWell No. 3 DeWitt "A"

C.H. Bay Company

COMPLETED

Contractor


NW NE SE

E11724
SECTION PLAT330 Ft. from N. Line

Ft. from S. Line

990 Ft. from E. Line

Ft. from W. Line

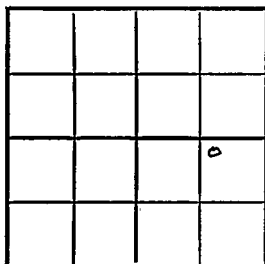

Rice County

Location

Rig up

Drilling and Remarks:

Per 83274
5" @ 3274
Pump 50 ft

42 9/16

RECORD

Cased _____ in., _____ ft.

Sand _____

Gas _____

Oil _____

Total Depth 3268

PRODUCTION

1st 24 hrs. Nat. _____

1st 24 hrs. after shot _____

Gas _____ Cu. Ft.

Dry Hole _____

Abandoned _____

Date

DEC 2 8 1945

19

S. J. LEWIS

Scout