

KANSAS


Rice

FORM 51 5M 4-41 PETROL

Section 9 Township 20 Range 9W

Well No. #3 Miller

Company Mabee oil

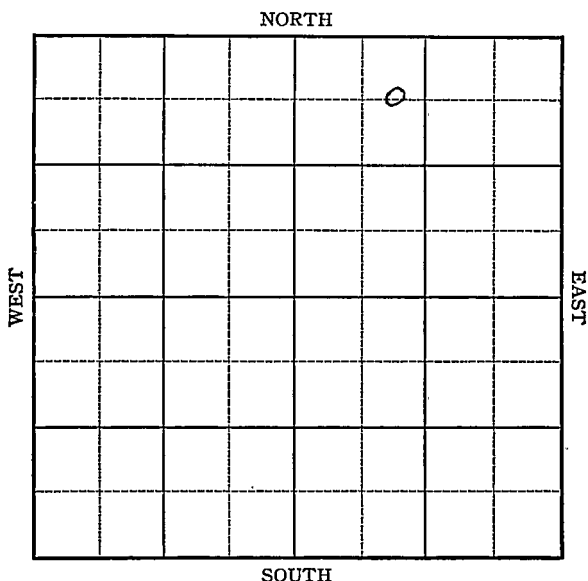


Sec. 9 Twp. 20 R. 9-WWell No. #3 Miller FarmMabee Oil Company

(Keesling)

660 Ft. from N. Line Ft. from S. Line Ft. from E. Line990 Ft. from W. Line

Elev. 1713

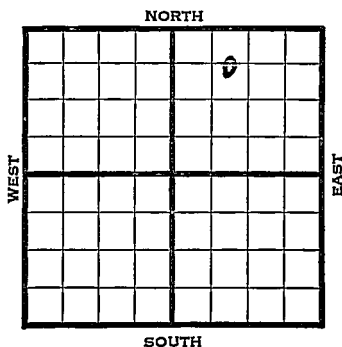

1941

REPORT

6/25

Location

7/3

"

7/10

10" - 200' WOC.

7/17

Drlg. 2565'

7/24

Arb 3225-26 TD 7" @ 3225 RUST

7/31

TD 3232- 2500' oil 10 hrs.

8/6

Arb 3225'

7" @ 3225'

TD 3232'

2000 acid

Pump 610 Potential

Gravity 43.8

COMPLETED

Map No. 49 Sec. 9 Twp. 20 R. 9WWell No. 3 MillerMabee Oil Company Contractor

FIRST REPORT

SECTION PLAT

C E L NW NE

660 Ft. from N. Line Ft. from S. Line Ft. from E. Line990 Ft. from W. Line

		o	

KEESLING POOL

Location XRig up

Drilling and Remarks:

RECORD

Cased in., ft.Sand Gas Oil Total Depth

PRODUCTION

1st 24 hrs. Nat. 1st 24 hrs. after shot Gas Cu. Ft.Dry Hole Abandoned

Date

JUN 25 1941 19 S. J. LEWIS Scout

KANSAS

Map No. 49 Sec. 9 Twp. 20 R. 9W.Well No. 3 MillerMabee Oil Company

Contractor

COMPLETED

SECTION PLAT

C E L NW NE

660 Ft. from N. Line Ft. from S. Line Ft. from E. Line990 Ft. from W. Line

KEESLING POOL

RECORD

Location Rig up

Drilling and Remarks:

*Ar 83225.**7" 83225.**2000 acid.**Pump 610 R.D.**43 E L*Cased in., ft.Sand Gas Oil Total Depth 8232

PRODUCTION

1st 24 hrs. Nat. 1st 24 hrs. after shot Gas Cu. Ft.Dry Hole Abandoned

Date

AUG 6 1941 19S. J. LEWIS Scout