

# KANSAS


FORM 51 5M 10-41 PETROL

Rice

Section 9 Township 20 Range 9-W

Well No. 3 Proffitt

Company Brown & Willard

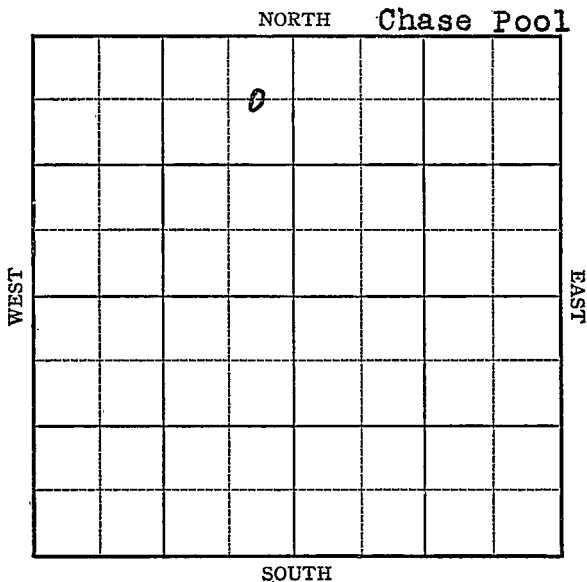



Rice

KANSAS

Map No. 49 Sec. 9 Twp. 20 R. 9WWell No. 3 ProffittBrown & Willard Company

FIRST REPORTS

Contractor

C EL NE NW

660 Ft. from N. Line       Ft. from S. Line330 Ft. from E. Line       Ft. from W. Line

## SECTION PLAT

|  |   |  |  |
|--|---|--|--|
|  |   |  |  |
|  | 0 |  |  |
|  |   |  |  |
|  |   |  |  |
|  |   |  |  |
|  |   |  |  |

CHASE POOL

Location                                 Rig up                                 

Drilling and Remarks:

Rotary

## RECORD

Cased            in.,            ft.Sand                                 Gas                                 Oil                                 Total Depth                                 

## PRODUCTION

1st 24 hrs. Nat.                                 1st 24 hrs. after shot                                 Gas                                  Cu. Ft.Dry Hole                                 Abandoned                                 

Date

JAN 7 1942

19

S. J. LEWIS Scout

Map No. 49 Sec. 9 Twp. 20 R. 9WWell No. 3 ProffittBrown & Willard CompanyCOMPLETED Contractor

C EL NE NW

660 Ft. from N. Line         Ft. from S. Line330 Ft. from E. Line         Ft. from W. Line

## SECTION PLAT

|  |   |  |  |
|--|---|--|--|
|  |   |  |  |
|  | o |  |  |
|  |   |  |  |
|  |   |  |  |
|  |   |  |  |
|  |   |  |  |

CHASE POOL

Location                                 Rig up                                 

Drilling and Remarks:

*Cr 3224*  
*5" @ 3226*  
*3000 acid*  
*Pump 549 P.D.*

*449 hr*

## RECORD

Cased                  in.,                  ft.Sand                                 Gas                                 Oil                                 Total Depth 3236

## PRODUCTION

1st 24 hrs. Nat.                                 1st 24 hrs. after shot                                 Gas                                  Cu. Ft.Dry Hole                                 Abandoned                                 

Date

FEB 11 1942 19 S. J. LEWIS Scout