


Section 9 Township 20 Range 9W

Well No. 4 DeWitt "A"

Company C. U. Bay

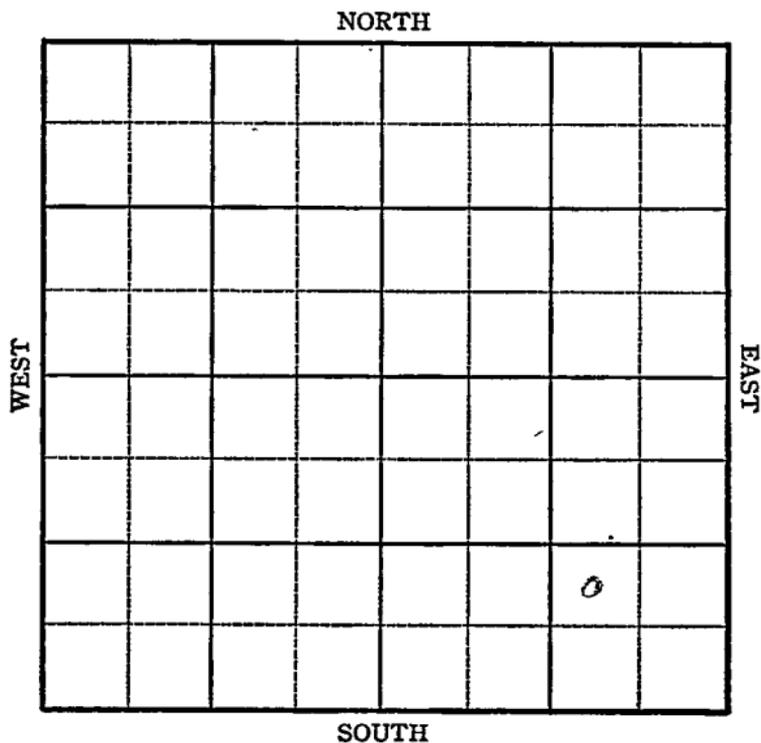

Sec. 9 Twp. 20 R. 9-W

Well No. #4 DeWitt "A" Farm


CU Bay Company

_____ Ft. from N. Line

990 Ft. from S. Line

990 Ft. from E. Line

_____ Ft. from W. Line

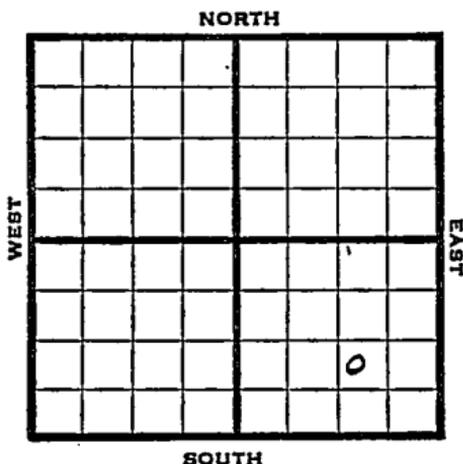

NW SE SE

1945 Elev. 1726' REPORT

11/28 Location

12/5 8" @ 222
Drilg. 2500

12/12 Arb. 3249-3264
TD 3264
5" @ 3252 RUST

12/20 " "

12/29 T.D. 3266' 500 acid.
Swab 2½ fluid per hour, 50% water.

1946

1/10 " "

1/17 " "

1/24 " "

1/31 " "

2/7 " "

2/14 " "

2/21 " "

2/28 " "

3/6 Arb. 3249
5" @ 3252
500 acid.
TD 3266
Pump 25 oil plus 25 W. Pot.
Grav. 41.2

COMPLETED

KANSAS Pool Name Silica

Map No. 49 Sec. 9 Twp. 20 R. 9W

Well No. 4 DeWitt "A"

CU Bay Company _____

FIRST REPORT Contractor _____

NW SE SE

SECTION PLAT

_____ Ft. from N. Line
990 Ft. from S. Line
990 Ft. from E. Line
 _____ Ft. from W. Line

			e

Rice County

Location X

Rig up _____

Drilling and Remarks:

RECORD

Cased _____ in., _____ ft.
 Sand _____
 Gas _____
 Oil _____
 Total Depth _____

PRODUCTION

1st 24 hrs. Nat. _____
 1st 24 hrs. after shot _____
 Gas _____ Cu. Ft.
 Dry Hole _____
 Abandoned _____

Date

NOV 28 1945 19

S. J. LEWIS Scout

