

KANSAS


Rice

FORM 51 5M 4-41 PETROL

Section 9 Township 20 Range 9-W

Well No. #4 Miller

Company Mabee Oil

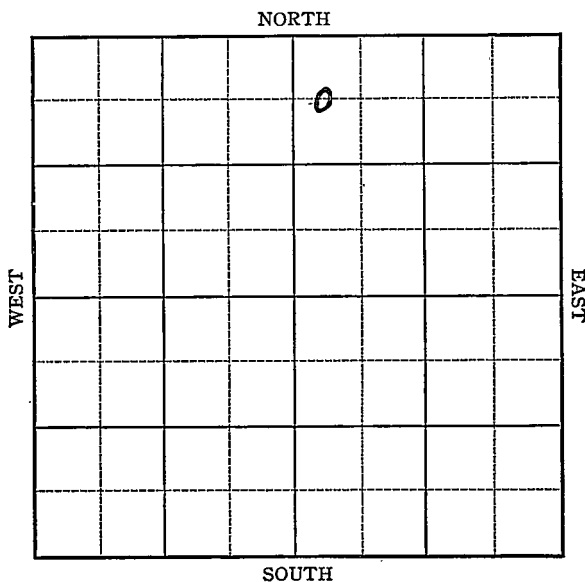

KANSAS


Rice

Sec. 9 Twp. 20 R. 9-WWell No. #4 Miller FarmMabee Oil Company

(Keesling)

660 Ft. from N. Line Ft. from S. Line Ft. from E. Line330 Ft. from W. Line

Elev. 1710

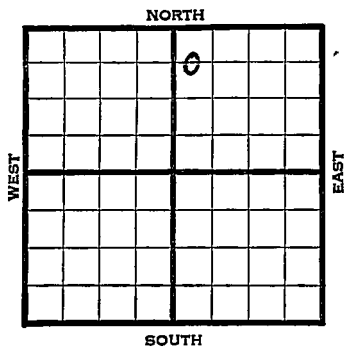

1941

REPORT

9/24

Rotary.

10/2

10" - 218' Drlg. 1848'

10/9

Lans. 2867' Drlg. 2947'

10/16

Arb. 3228-30' T.D. 6" - 3230'

RUST.

10/23

T.D. 3241' 725' oil 3 hours.

10/29

Arb. 3228'

6" - 3230'

T.D. 3243'

2000 acid.

Potential 307 bbls., pump.

43.8 Gravity

COMPLETED

Rice

KANSASMap No. K-49 Sec. 9 Twp. 20 R. 9WWell No. 4 MillerMabee Oil Company**FIRST REPORT**

Contractor

C WL NW NE

660 Ft. from N. Line Ft. from S. Line Ft. from E. Line330 Ft. from W. Line

KEESLING POOL

SECTION PLAT

		0	

Location Rig up

Drilling and Remarks:

Rotary

RECORD

Cased in., ft.Sand Gas Oil Total Depth

PRODUCTION

1st 24 hrs. Nat. 1st 24 hrs. after shot Gas Cu. Ft.Dry Hole Abandoned

Date

SEP 24 1941

19

S. J. LEWIS Scout

Map No. 11-49 Sec. 9 Twp. 20 R. 9WWell No. 4 MillerMabee Oil Company

Contractor

COMPLETED

C WL NW NE

660 Ft. from N. Line Ft. from S. Line Ft. from E. Line330 Ft. from W. Line

SECTION PLAT

		o	

KEESLING POOL

Location Rig up

Drilling and Remarks:

Cor 43225
6" @ 3230
2000 Revit
Pump 307 R.D.
435 Gr

RECORD

Cased in., ft.Sand Gas Oil Total Depth 3243

PRODUCTION

1st 24 hrs. Nat. 1st 24 hrs. after shot Gas Cu. Ft.Dry Hole Abandoned

Date

OCT 29 1941

19

S. J. LEWIS Scout