

KANSAS

Rice

FORM 51 5M PETROL

Section 9- Township 20 Range 9-~~W~~

Well No. #5 DeWitt "A"

Company C.U. Bay

							0

NORTH

WEST

EAST

SOUTH

Sec. 9 Twp. 20 R. 9-W

Well No. #5 DeWitt "A" Farm


C. U. Bay Company

990 Ft. from N. Line

 Ft. from S. Line

330 Ft. from E. Line

 Ft. from W. Line

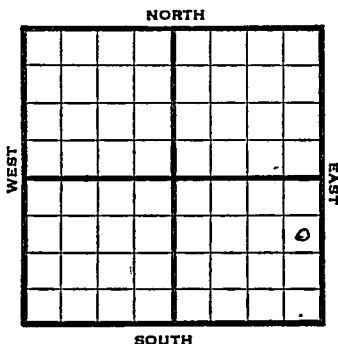

SE NE SE . . .

1945 Elev. 1722' REPORT

12/5 8" @ 210'
TD 225'

12/12 Drlg. 2840

12/20 Arb. 3240' T.D. 3242' 5" - 3242'
RUST.

12/29 T.D. 3253'

1946
1/10 " "
1/17 " "
1/24 " "
1/31 " "
2/7 " "
2/14 " "
2/21 " "

2/27 Arb. 3240
5" @ 3242
TD 3253'
Pump 30 Pot.
Grav. 42.3

COMPLETED

KANSAS

Kansas Pool Name SilicaMap No. K-49 Sec. 9 Twp. 20 R. 9WWell No. 5 DeWitt "A"C. U. Bay


Company

FIRST REPORT

Contractor

SE NE SE

SECTION PLAT

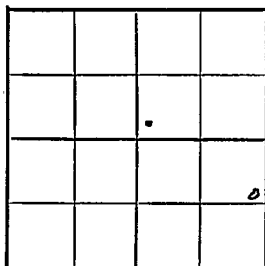990 Ft. from N. Line Ft. from S. Line330 Ft. from E. Line Ft. from W. LineRice CountyLocation Rig up

Drilling and Remarks:

8"-210225

RECORD

Cased in., ft.Sand Gas Oil Total Depth

PRODUCTION

1st 24 hrs. Nat. 1st 24 hrs. after shot Gas Cu. Ft.Dry Hole Abandoned

Date

DEC 5 194519S. J. LEWIS

Scout

Kansas Pool Name SilicaMap No. 49 Sec. 9 Twp. 20 R. 9WWell No. 5 DeWitt "A"

C. U. Bay

Company

COMPLETED

Contractor

SE NE SE

E1.1718
SECTION PLAT990 Ft. from N. Line Ft. from S. Line330 Ft. from E. Line Ft. from W. Line

			0

Rice County

Location Rig up

Drilling and Remarks:

Pr 32405' 3242Aug. 30 194642 3/4**RECORD**Cased in., ft.Sand Gas Oil Total Depth 3253**PRODUCTION**1st 24 hrs. Nat. 1st 24 hrs. after shot Gas Cu. Ft.Dry Hole Abandoned

Date

FEB 27 1946 19

S. J. LEWIS

Scout