

WELL PLUGGING RECORD


OR

FORMATION PLUGGING RECORD

Strike out upper line when reporting plugging off formations.

Give All Information Completely
Make Required Affidavit
Mail or Deliver Report to:
Conservation Division
State Corporation Commission
800 Bittling Building
Wichita, Kansas

NORTH

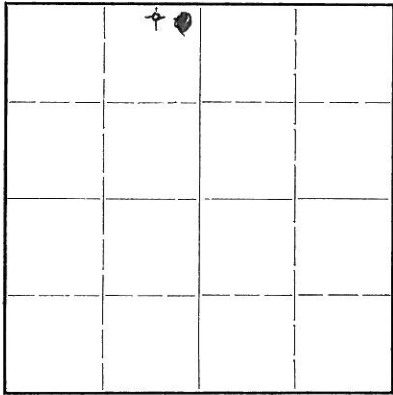

Locate well correctly on above Section Plat

McPherson County. Sec. 1 Twp. 21 Rge. (E) 1 (W)
Location as "NE 1/4 NW 1/4 SW 1/4" or footage from lines. NE 1/4 NW 1/4
Lease Owner. Both --- William Ebke, Powell Nebr.
Lease Name. Voth Well No. 1
Office Address.
Character of Well (completed as Oil, Gas or Dry Hole) Dry Hole
Date well completed. 11-28 - 1944
Application for plugging filed. 11-28 1944
Application for plugging approved. 11-28 1944
Plugging commenced. 11-28 1944
Plugging completed. 11-28 1944
Reason for abandonment of well or producing formation. dry hole

If a producing well is abandoned, date of last production. dry hole 19
Was permission obtained from the Conservation Division or its agents before plugging was commenced? yes

Name of Conservation Agent who supervised plugging of this well. Ruel Durkee McPherson, Ks.
Producing formation. Chat Depth to top. 2989 Bottom. 3027 1/2 Total Depth of Well. 3027 1/2 Feet
Show depth and thickness of all water, oil and gas formations.

OIL, GAS OR WATER RECORDS


CASING RECORD

Formation	Content	From	To	Size	Put In	Pulled Out
Surface	water	0	179	10 3/4"	179	Left In.
Chat	water	2989	3027 1/2	none	none	none

Describe in detail the manner in which the well was plugged, indicating where the mud fluid was placed and the method or methods used in introducing it into the hold. If cement or other plugs were used, state the character of same and depth placed, from... feet to ... feet for each plug set.

Hole filled with mud to bottom of surface, 179'. Plug with 25 sacks cement at 179' and filled with mud to bottom of cellar. Plug with 5 sacks cement at top of surface. Cellar filled.

1 21 1W
14 33

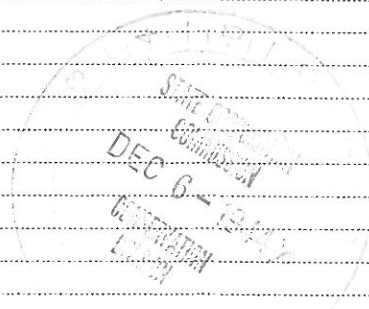

(If additional description is necessary, use BACK of this sheet)

Correspondence regarding this well should be addressed to William Ebke
Address. Powell, Nebr.

STATE OF Kansas COUNTY OF McPherson
Herbert Rhoton (employee/owner or (owner or operator) of the above-described well,
being first duly sworn on oath, says: That I have knowledge of the facts, statements, and matters herein contained and the log of the above-described well as filed and that the same are true and correct. So help me God.

(Signature) Herbert Rhoton
McPherson, Ks. (Address)

SUBSCRIBED AND SWORN to before me this 4th day of December, 1944.

My commission expires Sept. 14, 1946 Notary Public.