


WELL PLUGGING RECORD

Give All Information Completely
Make Required Affidavit
Mail or Deliver Report to:
Conservation Division
State Corporation Commission
800 Bittling Building
Wichita, Kansas

FORMATION PLUGGING RECORD

Strike out upper line
when reporting plug-
ging off formations.

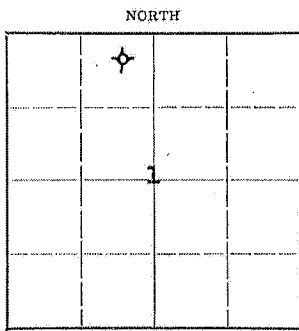

Locate well correctly on above
Section Plat

McPherson

County Sec. 1 Twp. 21 Rge. 1 (W)

Location as "NE 1/4 NW 1/4 SW 1/4" or footage from lines NW 1/4 NE 1/4 NW 1/4 NE NW NW

Lease Owner Albert W. Borell et. al.

Lease Name Wilson, Kansas. Voth Well No. 2

Office Address Wilson, Kansas.

Character of Well (completed as Oil, Gas or Dry Hole) Dry Hole

Date well completed 4/21 19 48

Application for plugging filed 4/21/ 19 48

Application for plugging approved Verbally 4/21 19 48

Plugging commenced 4/21 19 48

Plugging completed 4/21 19 48

Reason for abandonment of well or producing formation Dry

If a producing well is abandoned, date of last production none 19

Was permission obtained from the Conservation Division or its agents before plugging was commenced? yes

Name of Conservation Agent who supervised plugging of this well Eldon Petty, Great Bend, Kansas

Producing formation none Depth to top Bottom Original 3610 Feet

Show depth and thickness of all water, oil and gas formations. Total depth now 1400 Feet

OIL, GAS OR WATER RECORDS

CASING RECORD

Formation	Content	From	To	Size	Put In	Pulled Out
				8-5/8	153	none

Describe in detail the manner in which the well was plugged, indicating where the mud fluid was placed and the method or methods used in introducing it into the hole. If cement or other plugs were used, state the character of same and depth placed, from feet to feet for each plug set.

Well plugged early 1947 - Re-opened April 20, 1948, and washed down to 1,400 feet - Operation suspended.

Pumped heavy mud to 1,400 feet to bottom Surface Pipe - Put wood plug at 150 feet then 15 Sacks Cement and mud to 25 feet then wood plug then 10 Sacks Cement to Surface.

(If additional description is necessary, use BACK of this sheet)

Correspondence regarding this well should be addressed to Donald T. Ingling
Address 708 4th National Bank Building, Wichita 2, Kansas.

STATE OF KANSAS COUNTY OF SEDGWICK, ss.

I, D.T. Ingling (employee of owner) or (owner or operator) of the above-described well, being first duly sworn on oath, says: That I have knowledge of the facts, statements, and matters herein contained and the log of the above-described well as filed and that the same are true and correct. So help me God.

(Signature)

708 4th Nat'l Bank Bldg., Wichita 2, Kans

Subscribed and Sworn to before me this 24th day of April 19 48

Notary Public

My commission expires April 10, 1952

PLUGGING
FILE SEC. 1, 21, 21 W
BOOK PAGE 24 LINE 31

