


Section 1 Township 21 Range 14W

Well No. #1 Morrison

Company Plains Exploratinn

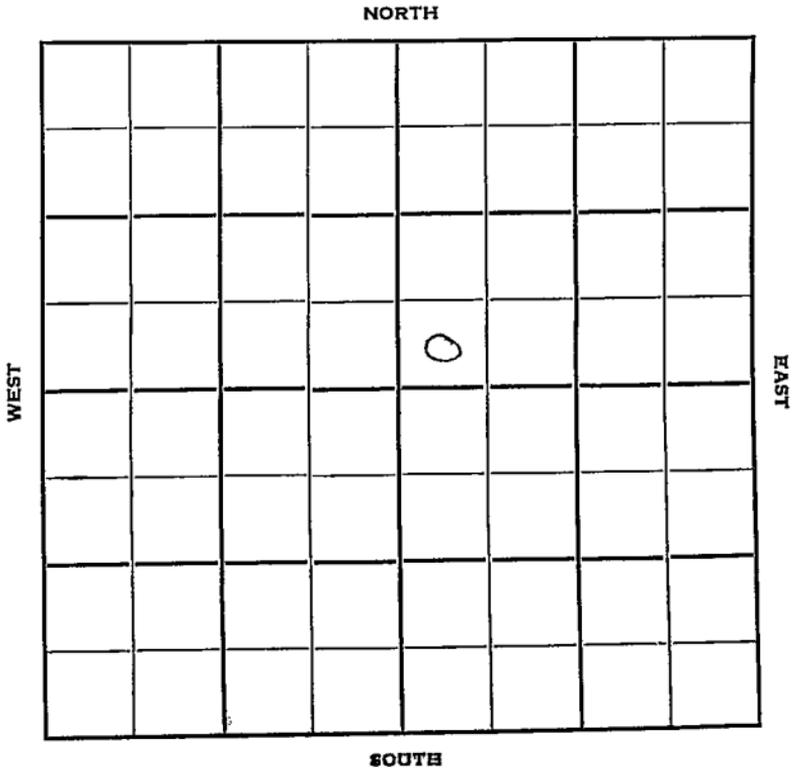

Sec. 1 Twp. 21 R. 14W

Well No. #1 Morrison Farm

Plains Exploration Company

Contractor

Wildcat


Ft. from N. Line

330' Ft. from S. Line

Ft. from E. Line

330' Ft. from W. Line

SW SW NE

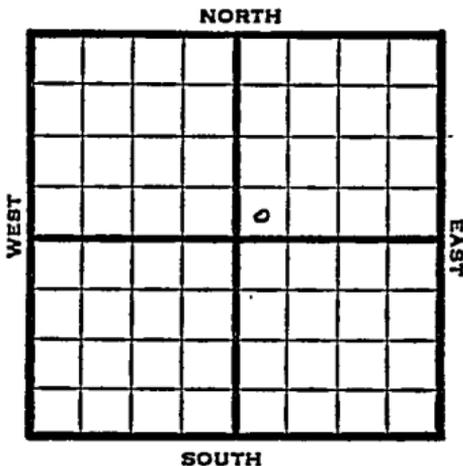

1950

Elev 1917'

REPORT

1/25
2/15

Location
TD 3626'
8" @ 350'
Heeb 3198'
Lans 3318'
Cong 3550'
Arb. 3601'
D&A
Aband.

ABANDONED


Map No. _____ Sec. 1 Twp. 21 R. 14WWell No. 1 Morrison

_____ Plains Exploration _____ Company

_____ Contractor

SW SW NE

SECTION PLAT

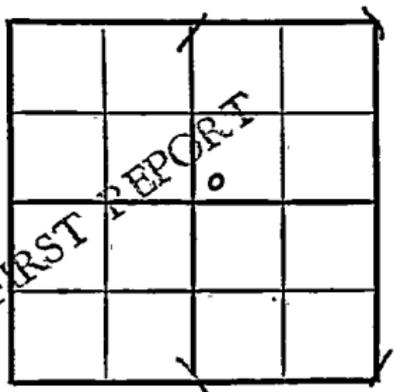

_____ Ft. from N. Line

330 Ft. from S. Line

_____ Ft. from E. Line

330 Ft. from W. Line

Stafford County

Location _____

Rig up _____

Drilling and Remarks:

RECORD

Cased _____ in., _____ ft.

Sand _____

Gas _____

Oil _____

Total Depth _____

PRODUCTION

1st 24 hrs. Nat. _____

1st 24 hrs. after shot _____

Gas _____ Cu. Ft.

Dry Hole _____

Abandoned _____

Date

JAN 25 1950 19J. E. TYRA

Scout

Map No. _____ Sec. 1 Twp. 21 R. 14W

Well No. 1 Morrison

Plains Exploration Company

Contractor

SW SW NE

E. 1917
SECTION PLAT

_____ Ft. from N. Line

330 Ft. from S. Line

_____ Ft. from E. Line

330 Ft. from W. Line

ABANDONED

Stafford County

Location _____

Rig up _____

Drilling and Remarks:

*8" @ 350
Hub 3198
Lans 3318
cong 3550
amb 3601.
D & A*

RECORD

Cased _____ in., _____ ft.

Sand _____

Gas _____

Oil _____

Total Depth 3626

PRODUCTION

1st 24 hrs. Nat. _____

1st 24 hrs. after shot _____

Gas _____ Cu. Ft.

Dry Hole _____

Abandoned _____

Date
FEB 15 1950

J. E. TYRA

Scout