

Section 1 Township 21 Range 15 WWell No. # 1 EnglishCompany Vickers Expl.

NORTH

			0				

WEST

EAST

SOUTH

Pawnee KANSAS

SEC.	TWP.	R.
1	21	15W ✓

WELL NO.

1 English

FARM

COMPANY

Vickers Expl.

CONTRACTOR


_____ Ft. from N. Line

990 _____ Ft. from S. Line

330 _____ Ft. from E. Line

_____ Ft. from W. Line

NE SE NW

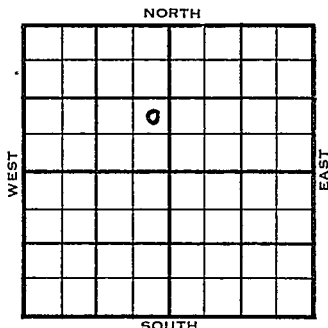

1953

ELEVATION

1918'

REPORT

11/18
12/2

Dr1g.
Spud 11-17-53
D & A TD 3620 8-5/8" @ 852
Anhy 849 Heeb 3161 Br line 3263
Lans. 3271 Cong. 3557
DST 3349-72, open 1 hr rec 175' SW
1100# TD 3620 D & A

ABANDONED

J. G. McGEHEE

NOV 20 1953

Scout Cards 92

Land Small Map BR

Land Wall Map BR

Tre. inge BR

France Map BR

Pierce Map BR

Misc. BR

Drly. Date

J. G. McGEHEE

Scout Cards	<i>mm</i>
Lynd Small Map	
Lynd Wall Map	<i>3</i>
Tracings	
France Map	
Pierce Map	
Misc.	

DEC 8

1952

Drig. Data