


Section 1 Township 21 Range 16W

Well No. #2 Smith "B"

Company Ben Brack

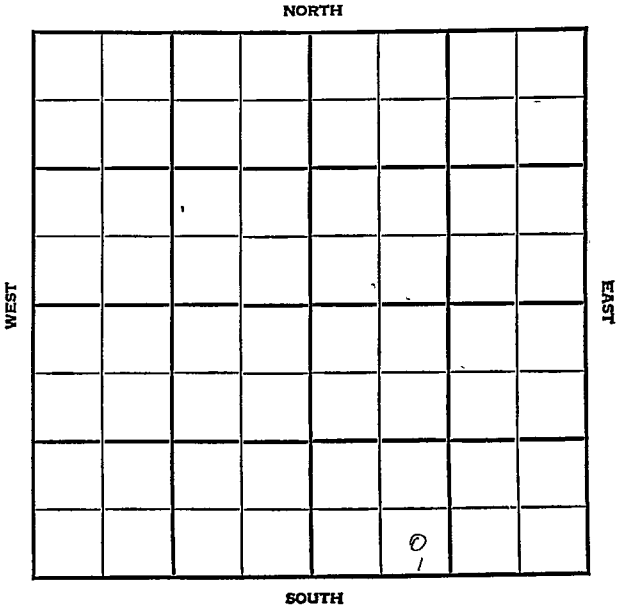



Sec. 1 Twp. 21 R. 16W

Well No. #2 Smith "B" Farm


Ben Brack Company  
Ash Creek

         Ft. from N. Line

330 Ft. from S. Line

         Ft. from E. Line

990 Ft. from W. Line

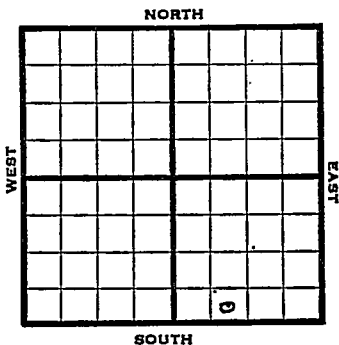

SE SW SE

1947 Elev. 1967' REPORT

11/19 Drlg. 910'

11/25 8" @ 957'  
Drlg. 3070'

12/3 Lansing 3414'  
Arbuckle 3750'  
TD 3773'  
5" @ 3773'  
RUST

12/10 TD 3779'  
Flow 5 bbls. oil PH 500 acid.

12/17 Arbuckle 3750'  
5" @ 3773'  
500 acid  
Flow 617 Pot  
Gravity 39  
TD 3779'

**COMPLETED**

Map No. \_\_\_\_\_ Sec. 1 Twp. 21 R. 16W

Well No. 2 Smith "B"

Ben Brack Company

**FIRST REPORT** Contractor

SE SW SE

**SECTION PLAT**

\_\_\_\_\_ Ft. from N. Line

330 Ft. from S. Line

\_\_\_\_\_ Ft. from E. Line

990 Ft. from W. Line


Pawnee County

Location \_\_\_\_\_

Rig up \_\_\_\_\_

Drilling and Remarks:

drlg. 910

**RECORD**

Cased \_\_\_\_\_ in., \_\_\_\_\_ ft.

Sand \_\_\_\_\_

Gas \_\_\_\_\_

Oil \_\_\_\_\_

Total Depth \_\_\_\_\_

**PRODUCTION**

1st 24 hrs. Nat. \_\_\_\_\_

1st 24 hrs. after shot \_\_\_\_\_

Gas \_\_\_\_\_ Cu. Ft.

Dry Hole \_\_\_\_\_

Abandoned \_\_\_\_\_

Date

NOV 1 0 1947 19

S I LEWIS Scout

