


Section.....1.....Township.....21.....Range.....8-III

Well Number.....1 - Heter.....

Company.....D. R. Lauck.....

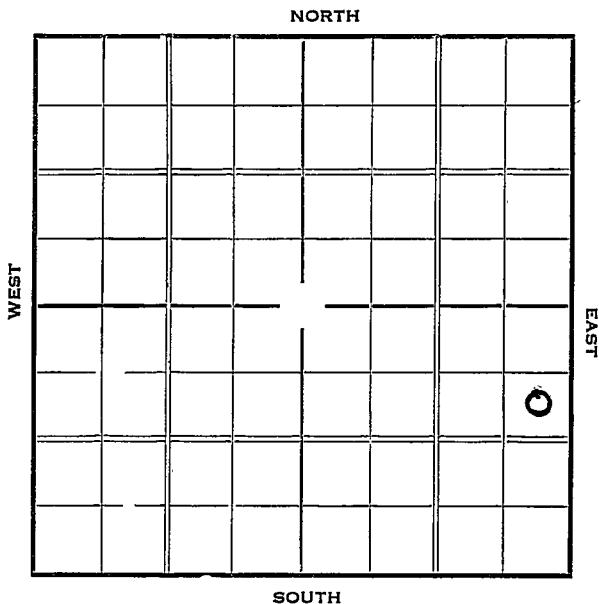

Sec. 1 Twp. 21 R. 8-W

Well No. #1 Heter Farm

D. R. Lauck Company


990 Ft. from N. Line

\_\_\_\_\_ Ft. from S. Line

330 Ft. from E. Line

\_\_\_\_\_ Ft. from W. Line

Elev. 1637

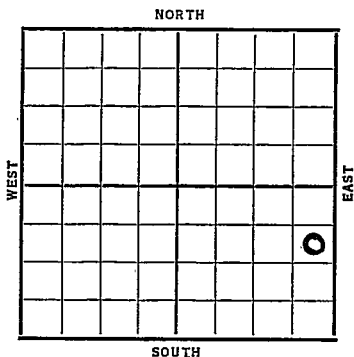

Date	REPORT
1937	
5/12	Pits.
5/21	"
5/28	15" @ 96'. WOC.
6/4	Drlg. 1912'.
6/11	T.D. 3122' SD.
6/19	Cong. 3341'. 7" @ 3341'.
	T.D. 3343'. H.F.O.
6/25	T.D. 3354½'.
	Shot 30 qts. C.O.
7/2	Testing.
7/9	"
7/14	7" @ 3341'.
	Cong. 3341'.
	T.D. 3352'.
	Shot 30 qts.
	Pumped 154 bbls. 6 hrs.
	Pot. 582 bbls.
	<b>COMPLETED</b>

*Rice* KANSAS

Map No. 49 Sec. 1 Twp. 21 R. 8<sup>W</sup>

Well No. 1 - Meter

D. R. Lauck Company

Contractor

**FIRST REPORT**

**SECTION PLAT**

990 Ft. from N. Line

1 Ft. from S. Line

330 Ft. from E. Line

\_\_\_\_\_ Ft. from W. Line


Location \_\_\_\_\_

Rig up \_\_\_\_\_

Drilling and Remarks:

*Pits*

**RECORD**

Cased \_\_\_\_\_ in., \_\_\_\_\_ ft.

Sand \_\_\_\_\_

Gas \_\_\_\_\_

Oil \_\_\_\_\_

Total Depth \_\_\_\_\_

**PRODUCTION**

1st 24 hrs. Nat. \_\_\_\_\_

1st 24 hrs. after shot \_\_\_\_\_

Gas \_\_\_\_\_ Cu. Ft.

Dry Hole \_\_\_\_\_

Abandoned \_\_\_\_\_

Date

MAY 12 1931 19

H. D. Hatfield Scout

Rice KANSAS

Map No. \_\_\_\_\_ Sec. 1 Twp. 21 R. 8WWell No. 1-HeterD. R. Lauck Company

Contractor

COMPLETED

## SECTION PLAT

			0

990 Ft. from N. Line

\_\_\_\_\_ Ft. from S. Line

330 Ft. from E. Line

\_\_\_\_\_ Ft. from W. Line

Location \_\_\_\_\_

Rig up \_\_\_\_\_

Drilling and Remarks:

Shot 30 galsPumped 154/6POT - 582

## RECORD

Cased 7 in., 3341 ft.~~Sand~~ Cong 3341

Gas \_\_\_\_\_

Oil \_\_\_\_\_

Total Depth 3352

## PRODUCTION

1st 24 hrs. Nat. \_\_\_\_\_

1st 24 hrs. after shot \_\_\_\_\_

Gas \_\_\_\_\_ Cu. Ft.

Dry Hole \_\_\_\_\_

Abandoned \_\_\_\_\_

Date

JUL 14 1937

19

H. D. Hatfield

Scout