


Section 1 Township 21 Range 12-W

Well No. #1 Brenn

Company E H Adair

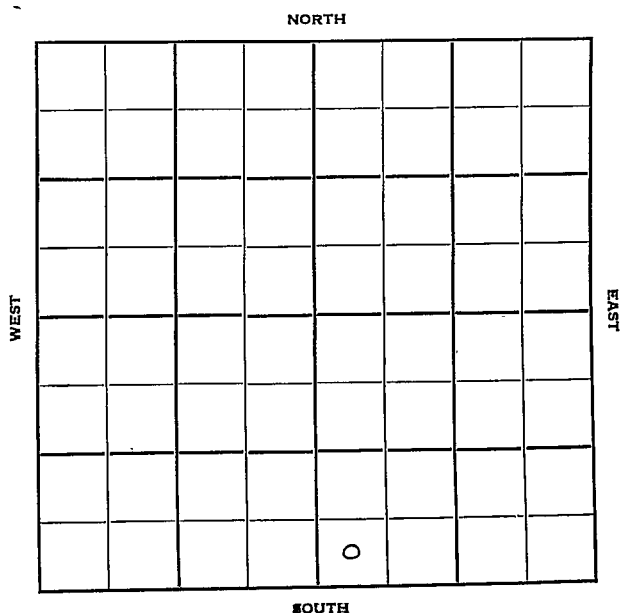

KANSAS

Stafford

Sec. 1 Twp. 21 R. 12-W

Well No. #1 Brenn Farm

E H Adair Company

E H Adair Contractor

Kowalsky SW


Ft. from N. Line

330 Ft. from S. Line

Ft. from E. Line

330 Ft. from W. Line

SW SW SE

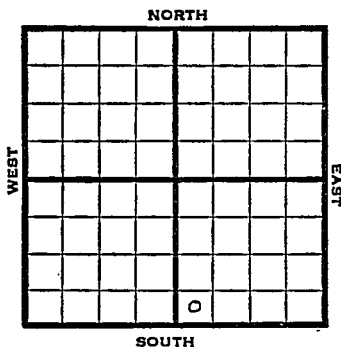

1950

Elev. 1819' REPORT

7/19

Spud 7-16-50
8" @ 247
drlg 1470

9/19


Spud 7-16-50
Oil Well TD 3498'
8" @ 247' Heeb 3036'
Br Lime 3164' Lans. 3185'
Cong. 3410' Arb. 3449-52
5" @ 3451' TD 3452'
S/1 boph 500 A
S/2 boph 1500 A S/4 BOPH DD 3498'
inc. in wtr PB 3458'
S/1 BOPH 2000A S/1 BO 1 BWPH
Comp. 25 BOPD, 25 BWPD

COMPLETED

Kansas

Map No. _____ Sec. 1 Twp. 21 R. 12WWell No. 1 Brenn_____
E. H. Adair Company_____
E. H. Adair Contractor
SW SW SE

SECTION PLAT

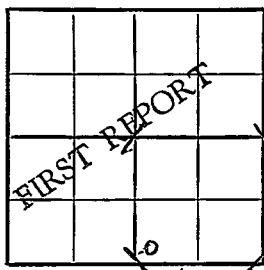Ft. from N. Line330 Ft. from S. Line_____
Ft. from E. Line330 Ft. from W. Line

Stafford County

Location _____

Rig up _____

Drilling and Remarks:

Spud 7-16-50

8" @ 247

drlg. 1470

RECORD

Cased _____ in., _____ ft.

Sand _____

Gas _____

Oil _____

Total Depth _____

PRODUCTION

1st 24 hrs. Nat. _____

1st 24 hrs. after shot _____

Gas _____ Cu. Ft.

Dry Hole _____

Abandoned _____


Date

JUL 19 1950

19

J. E. TYRA

Scout

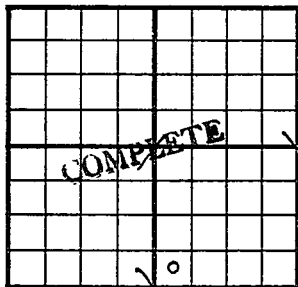County Stafford State KansasSec. 1 (Blk.
Twp.) 21 (Sur.
Rge.) 12W Map No.Operator H. H. AdairWell No. 1 Farm BrennElev. 1819 Location SW SW SE330 Ft. From S Line SE330 Ft. From W Line Quarter1st. Report SEP 20 1950Completion SEP 20 1950

Remarks

SW Kowalsky PoolSpudding Date 7-16-50Drlg. Data Oil well TD 34988" @ 247 Heeb. 3036 Br. lime 3164Lans. 3185 Cong. 3410 Arb. 3449-525" @ 3451 TD 3452 S/ 1 boph 500 AS/ 2 boph 1500 A S/ 4 boph DD 3498inc. in water PB 3458 S/ 1 boph2000 A S/ 1 bo 1 bwph Comp. 25 bopd
25 bwph

J. E. TYRA