

Section 1 Township 21 Range 12-WWell No. #1 CookCompany R. L. WilliamsS_and Hills Pool

NORTH

WEST

EAST

			8'				

SOUTH

KANSAS

Stafford



Sec. 1 Twp. 21 R. 12W

Well No. #1 Cook Farm

R. L. Williams Company

Sand Hills


660' Ft. from N. Line

Ft. from S. Line

330' Ft. from E. Line

Ft. from W. Line

SE NE NW

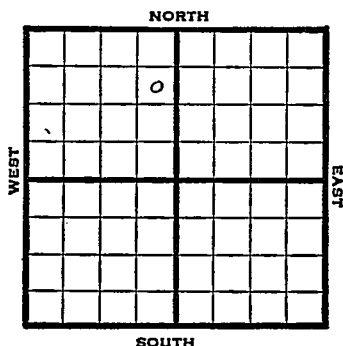

1948	Eli 1879'	REPORT
------	-----------	--------

6/23	RUR
6/29	8"@ 305'
7/14	Dr1g 1845'
	TD 3500'
	Arb. 3460'
	Abandoned
	ABANDONED

Map No. _____ Sec. 1 Twp. 21 R. 12W

Well No. 1 Cook

R. L. Williams Company

FIRST REPORT

Contractor

SE NE NW


SECTION PLAT

990 Ft. from N. Line

_____ Ft. from S. Line

330 Ft. from E. Line

_____ Ft. from W. Line

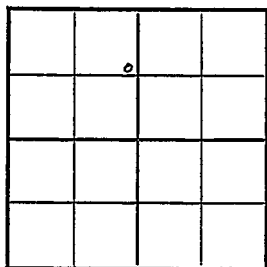

Stafford County

RECORD

Location _____

Rig up _____

Drilling and Remarks: _____

Cased _____ in., _____ ft.

* Sand _____

Gas _____

Oil _____

Total Depth _____

R U R

PRODUCTION

1st 24 hrs. Nat. _____

1st 24 hrs. after shot _____

Gas _____ Cu. Ft.

Dry Hole _____

Abandoned _____


Date

JUN 23 1948 19 S. J. LEWIS Scout

Map No. 46 Sec. 1 Twp. 21 R. 12WWell No. 1 CookR. L. Williams Company**ABANDONED**

Contractor

SE NE NW

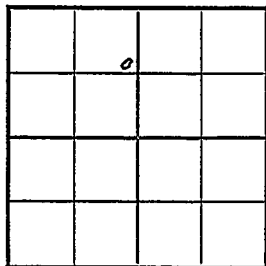E. 11877
SECTION PLAT990 Ft. from N. Line Ft. from S. Line330 Ft. from E. Line Ft. from W. Line

Stafford County

Location Rig up

Drilling and Remarks:

Per 78460

RECORD

Cased in., ft.Sand Gas Oil Total Depth 2500

PRODUCTION

1st 24 hrs. Nat. 1st 24 hrs. after shot Gas Cu. Ft.Dry Hole Abandoned

Date

JUL 14 1948

19

S. J. LEWIS

Scout