

KANSAS

Stafford

Section 1 Township 21 Range 12-W

Well No. #3 Cook

Company Imperial Oil

NORTH

						0	

WEST

EAST

SOUTH

Sec. 1 Twp. 21 R. 12-W

Well No. #3 Cook Farm

Imperial Oil Company

Snider Contractor


_____ Ft. from N. Line

990 _____ Ft. from S. Line

990 _____ Ft. from E. Line

_____ Ft. from W. Line

NW SE NE

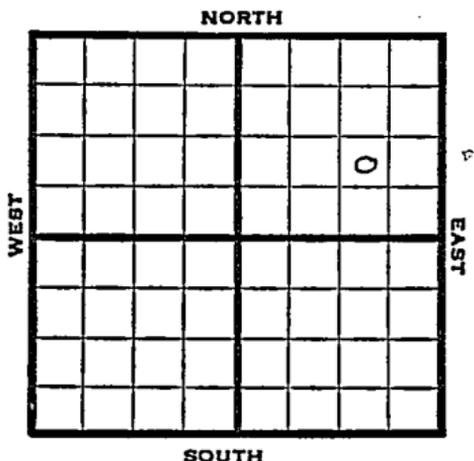

1950

Elev. 1820' REPORT

11/1

Location

12/27

Spud 11-5-50
 Oil Well TD 3445
 8" @ 280'
 Anhy 580' Top. 2744
 Heeb. 3020 Br. Lime 3142'
 Lans. 3158' Arb. 3427
 TD 3430 5" @ 3430
 DD 3437 1000 A S/3/4 boph
 1500 A S/1 1/2 bfp
 2000 A DD 3445 FU 250' oil 24hr.
 1000 A S/3 boph Comp. 42 bopd

COMPLETED

