


Section 10 Township 21 Range 13W

Well No. #2 Ewalt

Company Westgate-Greenland & Mallard

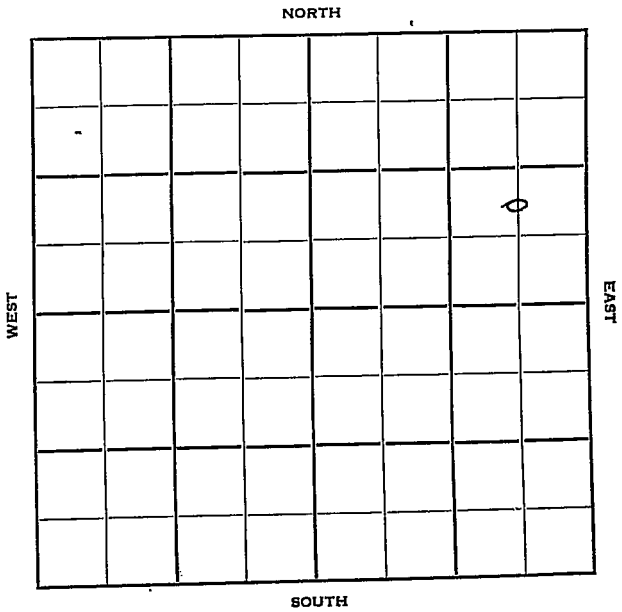

Sec. 10 Twp. 21 R. 13W

Well No. #2 Ewalt Farm

Westgate-Greenland & Mallard Company

Rothgarn Pool

\_\_\_\_\_ Ft. from N. Line

990'


\_\_\_\_\_ Ft. from S. Line

660'

\_\_\_\_\_ Ft. from E. Line

\_\_\_\_\_ Ft. from W. Line

C N $\frac{1}{2}$  SE NE

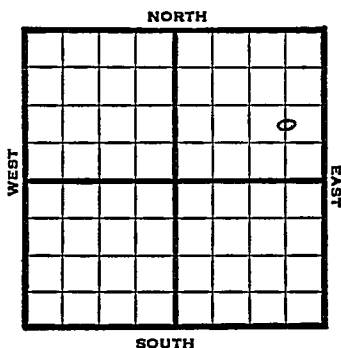

1950

Elev. 1880' REPORT

1/4

8-5/8" @ 290'

Drlg. 1100'

3/1

8" @ 290'

5" @ 3537'

Lans 3286'

Arb 3989'

190 BOPD, 14% wtr

TD 3553'

**COMPLETED**

**Kansas**

 Map No. \_\_\_\_\_ Sec. 10 Twp. 21 R. 13W
Well No. 2 Ewalt

Westgate-Greenland &amp; Mallard Company

Contractor

C  $N\frac{1}{2}$  SE NE

## SECTION PLAT

			o
		FIRST REPORT	

\_\_\_\_\_ Ft. from N. Line

990 Ft. from S. Line660 Ft. from E. Line

\_\_\_\_\_ Ft. from W. Line

Stafford County

## RECORD

Location \_\_\_\_\_

Cased \_\_\_\_\_ in., \_\_\_\_\_ ft.

Rig up \_\_\_\_\_

Sand \_\_\_\_\_

Drilling and Remarks:

Gas \_\_\_\_\_

Oil \_\_\_\_\_

Total Depth \_\_\_\_\_

8 5/8" @ 290drlg. 1100

## PRODUCTION

1st 24 hrs. Nat. \_\_\_\_\_

1st 24 hrs. after shot \_\_\_\_\_

Gas \_\_\_\_\_ Cu. Ft.

Dry Hole \_\_\_\_\_

Abandoned \_\_\_\_\_

Date

JAN 4 1950 19J.E. TYRA Scout

Kansas

Map No. \_\_\_\_\_ Sec. 10 Twp. 21 R. 13W

Well No. 2 Ewalt

Westgate-Greenland &amp; Mallard Company

Contractor

C N $\frac{1}{2}$  SE NEE1 1880  
SECTION FLAT

\_\_\_\_\_ Ft. from N. Line

990 Ft. from S. Line

660 Ft. from E. Line

\_\_\_\_\_ Ft. from W. Line

			o
COMPLETE			

Stafford County

Location \_\_\_\_\_

Rig up \_\_\_\_\_

Drilling and Remarks:

8" @ 290  
5" @ 3537  
Lans 3286  
arb 3989

190 BOPD

18% water

## RECORD

Cased \_\_\_\_\_ in., \_\_\_\_\_ ft.

Sand \_\_\_\_\_

Gas \_\_\_\_\_

Oil \_\_\_\_\_

Total Depth 3553

## PRODUCTION

1st 24 hrs. Nat. \_\_\_\_\_

1st 24 hrs. after shot \_\_\_\_\_

Gas \_\_\_\_\_ Cu. Ft.

Dry Hole \_\_\_\_\_

Abandoned \_\_\_\_\_

Date

J. E. TYRA

MAR 1 1950 19

Scout