


Section 10 Township 21 Range 13W

Well No. #3 Ewalt

Company Westgate-Greenland

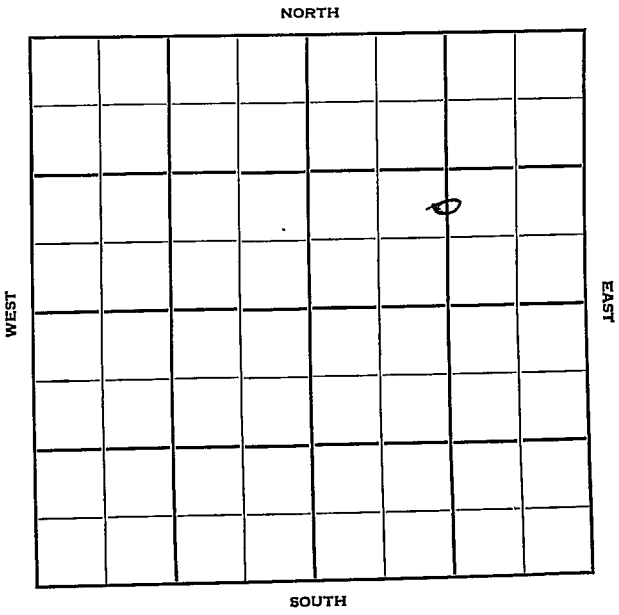

KANSAS

Stafford

Sec. 10 Twp. 21 R. 13-W

Well No. #3 Ewalt Farm

Westgate-Greenland Company

Contractor

Rothgarn Pool

 Ft. from N. Line


990 Ft. from S. Line

 Ft. from E. Line

1320
990 Ft. from W. Line

~~NE SW NE~~

CN 8 1/2 NE

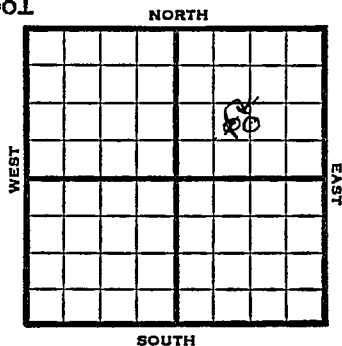

1950 Elev 1882 REPORT

2/1 Spud 1-31-50
Drlg

3/29 TD 3555'
8" @ 254'
5" @ 3549'
Lans 3291'
cong 3532'
Simp 3535'
Arb. 3549'
116 BOPD
28% Wtr.
Comp

COMPLETED

Kansas

Rothgarn Pool

Map No. _____ Sec. 10 Twp. 21 R. 13WWell No. 3 EwaltWestgate-Greenland

Company

Contractor

NE SW NE

SECTION PLAT

		1	
		0	

FIRST REPORT

Ft. from N. Line

990 Ft. from S. Line

Ft. from E. Line

990 Ft. from W. Line

Stafford County

Location _____

Rig up _____

Drilling and Remarks:

Spud 1-31-50
drlg.

RECORD

Cased _____ in., _____ ft.

Sand _____

Gas _____

Oil _____

Total Depth _____

PRODUCTION

1st 24 hrs. Nat. _____

1st 24 hrs. after shot _____

Gas _____ Cu. Ft.

Dry Hole _____

Abandoned _____

Date

FEB 1 1950

19

J. E. TYRA Scout

Map No. _____ Sec. 10 Twp. 21 R. 13W

Well No. 3 Ewalt

Westgate-Greenland

Company


CORRECTION

Contractor

C N L S $\frac{1}{2}$ NE

E/ 1882

SECTION PLAT

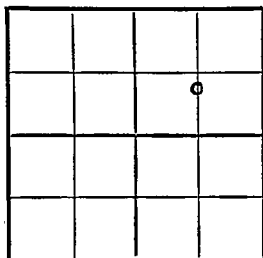

_____ Ft. from N. Line

990 Ft. from S. Line

1320 Ft. from E. Line

_____ Ft. from W. Line

Stafford County

Location _____

Rig up _____

Drilling and Remarks:

Reported

NE SW NE

RECORD

Cased _____ in., _____ ft.

Sand _____

Gas _____

Oil _____

Total Depth _____

PRODUCTION

1st 24 hrs. Nat. _____

1st 24 hrs. after shot _____

Gas _____ Cu. Ft.

Dry Hole _____

Abandoned _____

Date

FEB 8 1950 19

J. E. TYRA Scout

Kansas

Map No. _____ Sec. 10 Twp. 21 R. 13WWell No. 3 Ewalt

_____ Westgate-Greenland _____ Company

_____ Contractor


C N L S $\frac{1}{2}$ NEE1. 1882
SECTION PLAT

_____ Ft. from N. Line

_____ 990 Ft. from S. Line

_____ 1320 Ft. from E. Line

_____ Ft. from W. Line

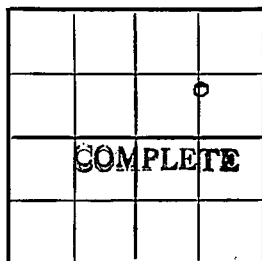

Stafford County

Location _____

Rig up _____

Drilling and Remarks:

8" @ 254
 5" @ 3549
 Sand 3291
 Cong 3532
 Sand 3535
 Arb 3549
 116 BOPD

RECORD

Cased _____ in., _____ ft.

Sand _____

Gas _____

Oil _____

Total Depth 3555

PRODUCTION

1st 24 hrs. Nat. _____

1st 24 hrs. after shot _____

Gas _____ Cu. Ft.

Dry Hole _____

Abandoned _____

Date

MAR 29 1950

J. E. TYRA

19

Scout