

KANSAS

Stafford


Section 10 Township 21 Range 13W

Well No. 3 Hiss "B"

Company Atlantic

Rothgarn Pool

NORTH

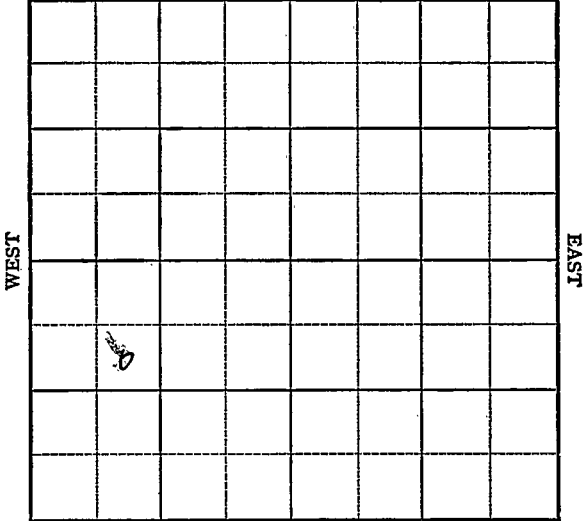

SOUTH

KANSAS

Stafford

✓
13W

Sec. 10 Twp. 21 R. 13W


Well No. #3 Hiss "B" Farm _____

Atlantic

Company

Rothgarn Pool

NORTH

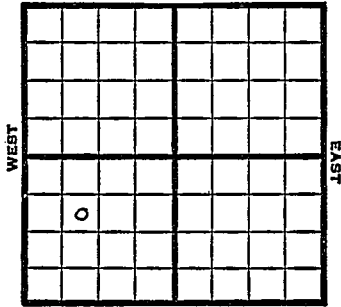

990' Ft. from N. Line

_____ Ft. from S. Line

_____ Ft. from E. Line

990' Ft. from W. Line

SE NW SW

SOUTH

1949

Elev 1888'

REPORT

- 2/23 Locatinn
- 3/2 RUR
- 3/8 8" @ 273'
- 3/16 Drlg. 2935'
- 3/23 TD 3660' in Cong
Lans. 3316
Cong 3547'
Aband.

ABANDONED

Map No. _____ Sec. 10 Twp. 21 R. 13W

Well No. 3 Hiss "B"

Atlantic Company

FIRST REPORT Contractor

SE NW SW

SECTION PLAT

990 Ft. from N. Line

_____ Ft. from S. Line

_____ Ft. from E. Line

990 Ft. from W. Line

Stafford County

Location X

Rig up _____

Drilling and Remarks:

RECORD

Cased _____ in., _____ ft.

Sand _____

Gas _____

Oil _____

Total Depth _____

PRODUCTION

1st 24 hrs. Nat. _____

1st 24 hrs. after shot _____

Gas _____ Cu. Ft.

Dry Hole _____

Abandoned _____

Date

FEB 23 1949 19

S. J. LEWIS Scout

Scout Cards

Land Small Map

Land Wall Map

Tracings

France Map

Pierce Map

Misc.

Kansas

Map No. 87 Sec. 10 Twp. 21 R. 13W

Well No. 3 Hiss "B"

Atlantic Company

ABANDONED

Contractor

E 11888

SE NW SW

SECTION PLAT

990 Ft. from N. Line

_____ Ft. from S. Line

_____ Ft. from E. Line

990 Ft. from W. Line

Stafford County

RECORD

Location _____

Cased _____ in., _____ ft.

Rig up _____

Sand _____

Drilling and Remarks:

Gas _____

Lans 3316

Oil _____

Comp 3547

Total Depth *2660 in Comp*

PRODUCTION

1st 24 hrs. Nat. _____

1st 24 hrs. after shot _____

Gas _____ Cu. Ft.

Dry Hole _____

Abandoned _____

Date

MAR 23 1949 19

S. J. LEWIS

Scout

Scout Cards.....
Land Small Map.....
Land Wall Map.....
Tracings.....
France Map.....
Pierce Map.....
Misc.

Edith
D
A
A