

KANSAS


Stafford

FORM 51 5M 1-42 PETROL

Section 10 Township 21 Range 13-W

Well No. #1 Hiss "B"

Company Atlantic

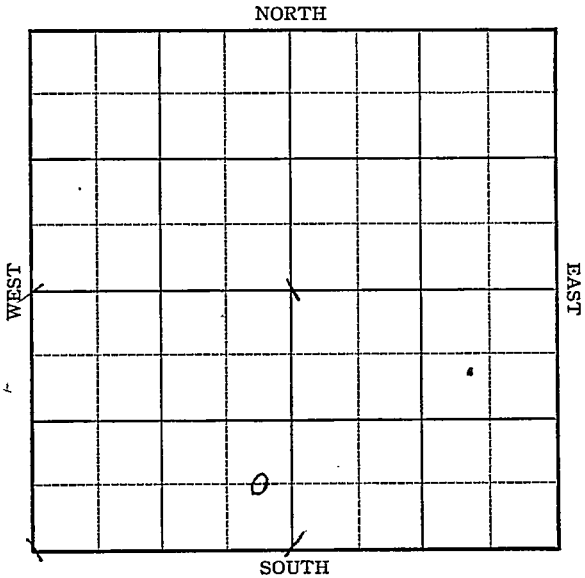

KANSAS

Stafford

Sec. 10 Twp. 21 R. 13-W

Well No. #1 Hiss "B" Farm

Atlantie Company

Rothgarn


 Ft. from N. Line

660 Ft. from S. Line

330 Ft. from E. Line

 Ft. from W. Line

elec. 1881

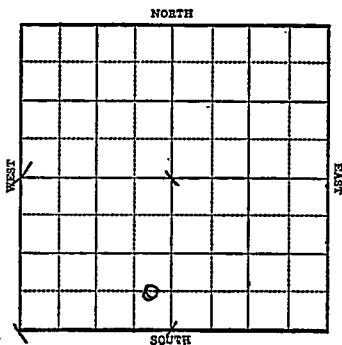

1943

R E P O R T

- 6/2 Derrick
- 6/9 10" @ 261 WOC.
- 6/16 Drig. 3511
- 6/23 Arb 3552-55½ T.D.
7" @ 3552 Rust
- 6/30 T. D. 3560-750' oil 6 hrs.
- 7/7 2000 acid
SD for tanks
- 7/15 " "
- 7/21 " "
- 7/28 Arb. 3552
7" @ 3552
T.D. 3560'
2000 acid
Depth Pot 2787'
Gravity 36

COMPLETED

KANSAS

Map No. 87 Sec. 10 Twp. 21 R. 13WWell No. 1 His s "B"Atlantic CompanyCOMPLETED Contractor

C E L S E S W

SECTION PLAT

_____ Ft. from N. Line

660 Ft. from S. Line330 Ft. from E. Line

_____ Ft. from W. Line

ROTHGARN POOL

Location _____

Rig up _____

Drilling and Remarks:


RECORD

Cased _____ in., _____ ft.

Sand _____

Gas _____

Oil _____

Total Depth 3560

PRODUCTION

1st 24 hrs. Nat. _____

1st 24 hrs. after shot _____

Gas _____ Cu. Ft. :

Dry Hole _____

Abandoned _____

Date

JUL 28 1943

19

S. J. LEWIS Scout