


Stafford

KANSAS

SECTION 10 TOWNSHIP 21 RANGE 14 W

WELL NO. #1 Shepherd

COMPANY Lewis Drlg.

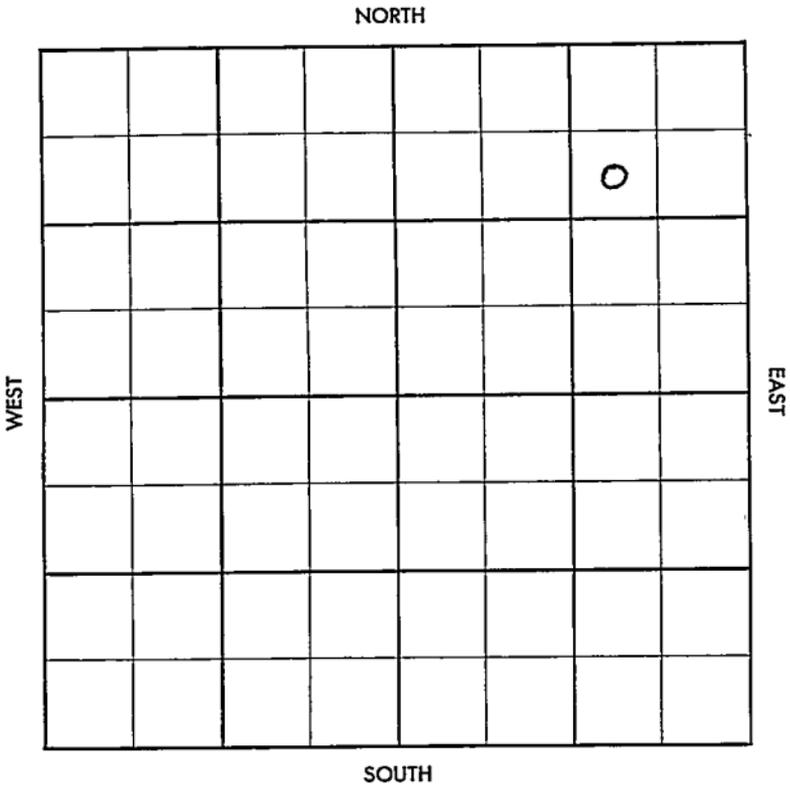

Stafford KANSAS


SEC. 10 TWP. 21 R. 14 W

WELL NO. # 1 Shepherd FARM

COMPANY Lewis Drlg.

CONTRACTOR Co. tools Wildcat

_____ Ft. from N. Line
 _____ Ft. from S. Line
 _____ Ft. from E. Line
 _____ Ft. from W. Line

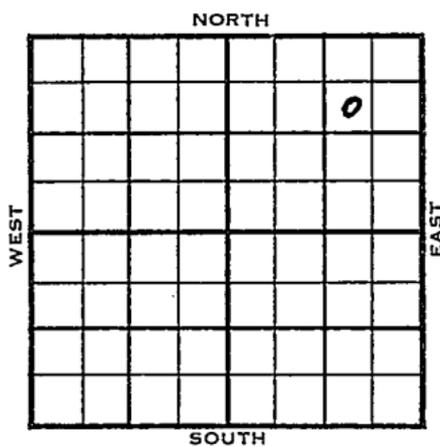

SW NE NE

SDX - 1/2 Mile

1955 ELEVATION REPORT

- 12/21 RUR
- 12-29 Spud 12-23-55
8 5/8" @ 831/220
Drlg. 2540
- 1956
- 1-6 Heeb. 3227 1/2
Tor. 3251
Doug. 3269
Br. lime 3345
Lans. 3355
Arb. 3695
DST 3474-85, op 1 hr. rec. 2135' free
oil, 120' ocm, 1100#
5 1/2" @ 3650
TD 3725'
- 1-12 5 1/2" @ 3606/125
WOCT
- 1-19 CO to 3582, ran LW log,
Re-cement 5 1/2" @
CO to 3495
30/ 3482-87,
SP 3489, 2500 A
F/ 12,80 boph.
- 1-26 F/ 14 boph 5 hrs., POP
- DX-78 2-2 Waiting on potential

~~Stafford~~

County Stafford Elev. _____
 Sec. 10 Twp. 20 Rge. 11W
 Company Lewis Drlg.
 Farm Name Shepherd No. 1

TOPS	DEPTH	LOG	DATUM	Loc. in Sec.
Anh.				SW NE NE
Tp.				
H.				
Tr.				
Dg.				
Bl.				
L.				
K.C.				Geol. _____
B.K.C.				Contr. _____
Ce.				Co. tools -
C.				
M.				
M.				Pool _____
K.				Wildcat
Mz.				
Me.				
V.				
S.				
S.				
A.				
R.				
PE.				
G.				
T.D.				

SDX -

10
 1/2 mile
 FIRST REPORT
 DEC 21 '55

Date Comm. _____
 R O H

~~Shepherd~~

Co.
 L. Sec.
 No.
 Sec.
 T.
 R.

DEC 27 1955

M. M.

County Stafford Elev. 1926
 Sec. 10 Twp. 21 Rge. 14W
 Company Lewis Drlg.
 Farm Name Shepherd No. 1

Co.

TOPS	DEPTH	LOG	DATUM	Loc. in Sec.
Asht.				SW NE NE
TP				
H.	3227	3226		
Tc.	3251			
Sp.	3269			
Bl.	3345	3344		
L.	3355	3355	1429	Geol.
K.C.				
B.C.C.		3580	1654	Contr.
Ce.				Co. tools
C.				Taylor ext.
M.				Pool
M.				Wildcat
M.				
V.		3588	1662	COMPLETE
S.		3636	1710	
A.	3695	3686	1760	Similar
R.				
T.				
C.				
TD	3725	3721		

Sec.

No.

Sec.

T.

R.

Date Comm. FEB 15 1956

RUR DEC 28 55 12-23-55 878

831/220 10 2540 JAN 5 56

DST 3474-85 1hr ne 2135'

Free oil + 120' OCM BHP 1100

5 1/2 3580/200 JAN 11 5 1/2 3606/125

WOST JAN 18 56 CO 3582 LWL

Re cement 5 1/2 CO 3495 30'

3482-87 (S.O.) P19 3489 12 1/2'

Flw 12.80 Doph nolw 1/2" ch.

FEB 27 1956

R. G.

JAN 25 '56 Flus 14 Bopk n/w
Shoal Pop FEB 1 '56 3100 w 2 pat
FEB 8 '56 W. & Pat (not pumping)
FEB 15 '56 X No 1st 100 Pat
Ph. P. 198 Bopd n/w
gran 36°