

Stafford


KANSAS

11W

SECTION 10 TOWNSHIP 21 RANGE _____

WELL NO. #3 Shepherd

COMPANY Lewis Drlg. Co.

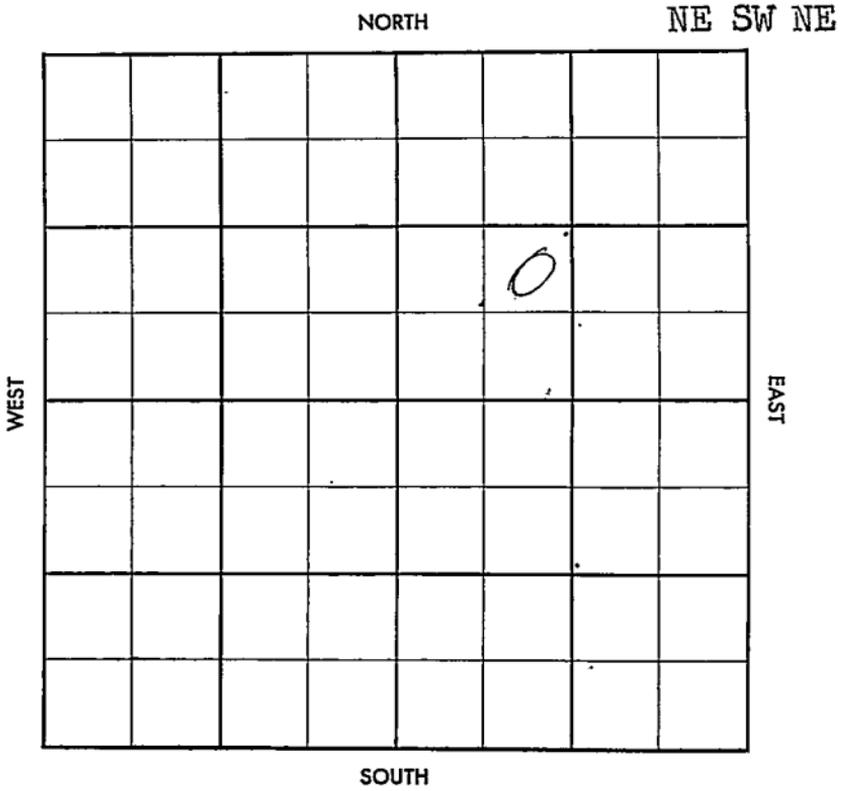


SEC. 10	TWP. 21 S	R. 14 W
------------	--------------	------------

WELL NO. # 3 Shepherd FARM

COMPANY Lewis Drlg. Co.

CONTRACTOR Lewis Tools
Taylor

_____ FT. FROM N. LINE
 _____ FT. FROM S. LINE
 _____ FT. FROM E. LINE
 _____ FT. FROM W. LINE

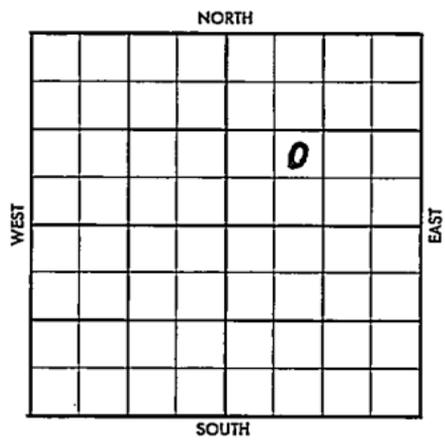

NE SW NE

SDX-1/4 Mile

	ELEVATION	REPORT
--	-----------	--------

1957		
6/12	Comm. 6-10-57 8" @ 830/475 WOC	(FR Tkt)

County Stafford Elev. _____
 Sec. 10 Twp. 21 Rgs. 1 1/4 W
 Company Lewis Drlg. Co.
 Farm Name Shepherd No. 3

TOPS	DEPTH	LOG	DATUM	Loc. in Sec.
Anh.				NE SW NE
Tr.				
Dg.				
Bl.				
L.				Geol. <u>Mayfield & Smith</u>
K.C.				Contr.
B.K.C.				<u>Lewis Tools</u>
Ce.				Pool
C.				<u>Taylor</u>
M.				
M.				
K.				
Mz.				
Me.				
V.				
S.				
S.				
A				
R.				
Pe.				
G.				
T.D.				

Geol. Mayfield & Smith
 Contr.
Lewis Tools
 Pool
Taylor

FIRST REPORT
 JUN 12 37
 $\frac{1}{4}$ mile

Date Comm. 6-10-57
8" @ 830/475 WOC

~~13~~

17 M

Co.
Lse.
No.
Sec.
T.
R.

County 55 1070 Elev. 1932
10 21 Reg. 1411
Lewis Brlg. Co.
Shepherd No. 3

TOPS	DEPTH	LOG	DATUM	Loc. in Sec.
Anh.				
TP.				
H.	3238			
Tr.				
Dg.				
BL.	3355			
L.	3365			
K.C.				Geol. <u>3578</u>
B.K.C.	3578			Contr.
Ce.				Lewis Tools
C.				
M.				Pool
M.				Taylor
K.				
Mz.				
Ma.				
V.				
S.				
S.				
A.				
R.				
PE.				
G.				
TD.	3585			

ABANDONED
 JUL 17 '59
 1/4 mile
 4

Date Comm. 6-1-59
5" 330/475, WOC JUN 17 '59 MD 2850
DST 3479-95 1hr 20'
Md BHP 635/20 DST 3560
-72 or 20" 2' Md BHP
0/20 5 1/2 3549/120 WOC
JUL 10 '59 ✓ CO 3520 16/
3488-93 7st all wh
DCA