


Stafford

KANSAS

SECTION 10 TOWNSHIP 21S RANGE 14W

WELL NO. #4 Shepherd

COMPANY Murfin Drlg.

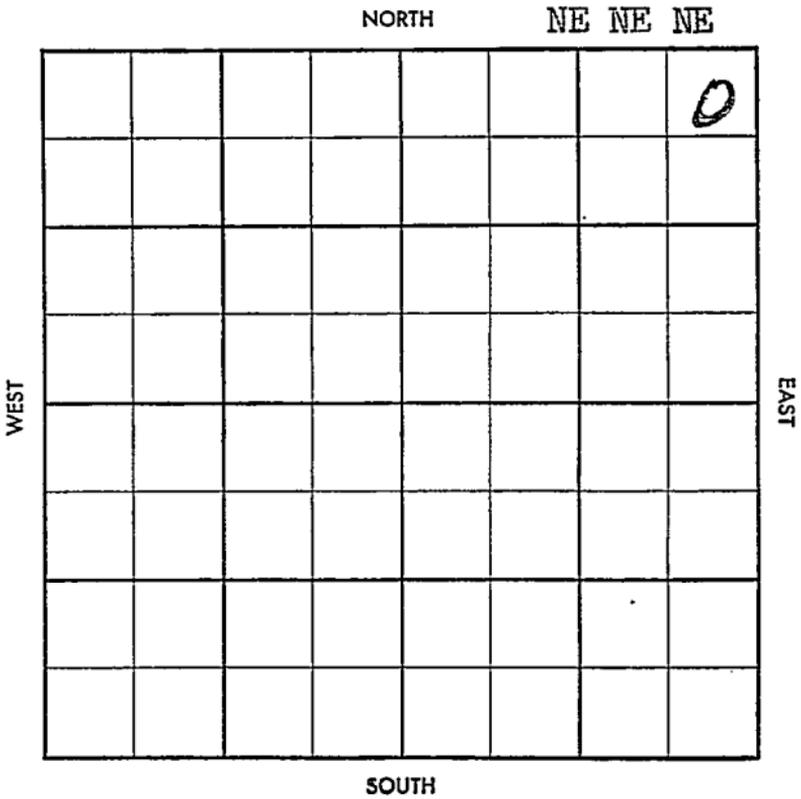

~~18~~

County Stafford Elev. \_\_\_\_\_  
 Sec. 10 Twp. 21 Rge. 1 LW  
 Company Murfin Drig.  
 Farm Name Shepherd No. 4

TOPS	DEPTH	LOG	DATUM
Anh.			
Tp.			
H.			
Tr.			
Dg.			
B.L.			
L.			
K.C.			
B.K.C.			
Ce.			
C.			
M.			
M.			
K.			
Mz.			
Mq.			
V.			
S.			
S.			
A.			
R.			
Pf.			
G.			
T.D.			

Loc. in Sec. \_\_\_\_\_  
NE NE NE

Geol. \_\_\_\_\_  
 Contr. \_\_\_\_\_  
Murfin

Pool \_\_\_\_\_  
NE Taylor

**WATER REPORT**  
 FEB 19 1938

Date Comm. \_\_\_\_\_  
M I R

Co.  
Lse.  
No.  
Sec.  
T.  
R.

Twp. ~~X~~ Pool ~~X~~  
~~On~~ ~~Face~~

S-513-B

County Stafford Elev 1721 DE 1940  
 Sec. 10 Twp. 21 Rge. 1 NW  
 Company Murfin Drlg.  
 Farm Name Shepherd No. 4

TOPS	DEPTH	LOG	DATUM
Anh.			
Tp.			
H.	3223		
Tr.	3242		
Dg.	3262		
B.L.	3333		
L.	3348		
K.C.			
B.K.C.			
Ce.			
C.			
M.			
M.			
K.			
Mz.			
Mq.			
V.			
S.			
S.			
A.	3667		
R.			
Pf			
G.			
T.D.	3775		

Loc. in Sec. I<sup>II</sup> N J.  
 Geol. \_\_\_\_\_  
 Contr. Murfin  
 Pool NE Taylor

**ABANDONED**  
 MAY 4 58

Date Comm. 2-19-58  
 M I R 8" 260/125 Ø 3075  
~~M I R~~ 5" 3700/75 MAR 12 58  
DST 3462-80 60" 7' M BHPD  
DST 3540-57 60" 12' 50 CM 1'  
free oil BHPD DST 3669-73  
60" 20' MD 30' 04 WCM BHP  
1120 WOLT MAR 19 58 MAR 27 58  
 APR 9 58 APR 14 58 APR 23 58 APR 30 58 MAY 7 58  
MAY 14 58  
CO 369/ 12/3669-72 FU  
75' fld 15" PB 3580

Cont.  
 Ise.  
 No.  
 Sec.  
 T.  
 R.

16/3551-55 B 590 + 1BW ph NT

8/3543-45 NO INCREASE 2000 A

FU 60' oil 2480' W PB 3500

25/3469-74 FU 20' oil 2460'

W 59 3469-74 CO report 25/

3469-74 A FU 2' oil 2190' W

CO 3691 SQ all parts CO 3775

SW DW 3700-3775