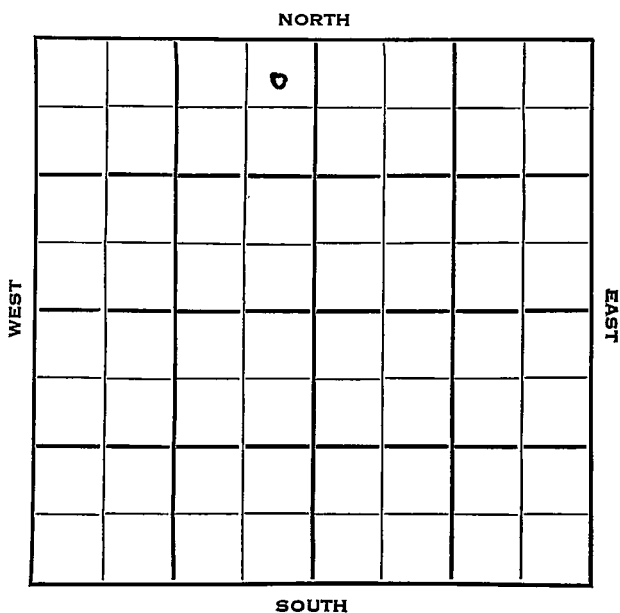


Section 10 Township 21 Range 15 WWell No. # 1 Bowman "B"Company Vickers Expl. Ltd.

Pawnee.

KANSAS ✓


Sec. 10 Twp. 21 R. 15WWell No. #1 Bowman "B" FarmVickers Expl. Ltd. Company

Contractor

330 Ft. from N. Line Ft. from S. Line330 Ft. from E. Line Ft. from W. LineNE NE NW
Magnolia F/O

Atl. DHM

1953 Elev. 1935' REPORT

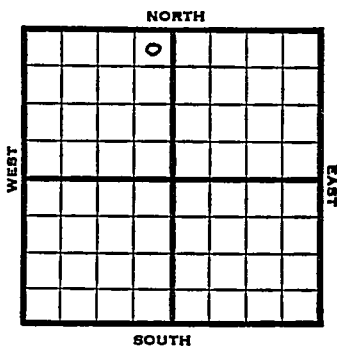

8/26 Spud 8-25-53

Anhy 902'

8" @ 912'

WOC

9/2 Drlg 3010'

9/9 Spud 8-25-53

D&A

TD 3773

Anhy 902'

8" @ 912'

Heeb 3285, Br lime 3383, Lans

3394, Cong 3656, Viola 3667, Simp

3691, Arb. 3748

TD 3773

D&A

ABANDONED

County **Pawnee** State **Kansas**

Sec. 10 (Blk.) 21 (Sur.) 15W Map No.

Operator Vickers Expl. Ltd.

Well No. 1 Farm Bowman "B"

Elev.	Location	NE NE NW

FIRST	REPORT		

330 Ft. From N Line NW

330 Ft. From E Line Quarter

1st. Report AUG 26 1953

Completion


Remarks	Magnolia farmout Atl. DEM
---------	------------------------------

Spudding Date 8-25-53

Drlg. Data

Army 902 8" @ 912 WOC

County Pawnee State Kansas
 Sec. 10 (Blk. 21 (Sur. 15W Map No.
 (Twp.) (Rge.)
 Operator Vickers Expl. Ltd.
 Well No. 1 Farm Bowman "B"
 Elev. 1935 Location NE NE NW

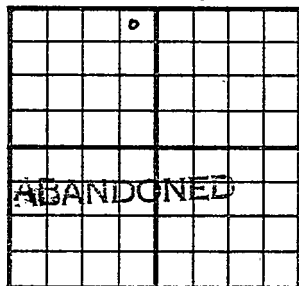

330 Ft. From N Line NW
330 Ft. From E Line Quarter
 1st. Report

Completion SEP 9 1953

Remarks

Spudding Date 8-25-53

Drilg. Data D & A TD 3773

Anhy 902 8" @ 912 Heeb. 3285

Br. lime 3383 Lans. 3394 Cong. 3656

Viola 3667 Simp. 3691 Arb. 3748

TD 3773

D & A