

KANSAS Rice

Section 10 Township 21 Range 7WWell No. 1 DeweeseCompany Petroleum Inc.

Wherry Pool

NORTH

WEST	0		.							EAST

SOUTH

KANSAS

Rice



Sec. 10 Twp. 21 R. 7W

Well No. 1 Deweese Farm
Petroleum Inc. Company

Wherry Pool


330 Ft. from N. Line

 Ft. from S. Line

 Ft. from E. Line

330 Ft. from W. Line

NW/8

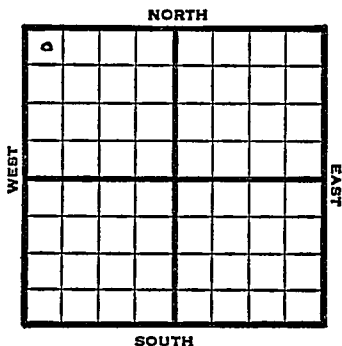

1948	Eli 1610'	REPORT
11/17	8" @ 93'	
	Drlg. 3100'	
11/23	TD 3430'	
	Cong 3407'	
	Aband.	
	ABANDONED	

Map No. _____ Sec. 10 Twp. 21 R. 7W

Well No. 1 Deweese

Petroleum Inc. _____ Company

FIRST REPORT

Contractor _____

NW/C


SECTION PLAT

330 Ft. from N. Line

_____ Ft. from S. Line

_____ Ft. from E. Line

330 Ft. from W. Line

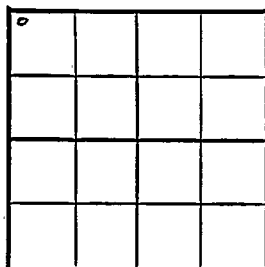

Rice County

Location _____

Rig up _____

Drilling and Remarks: _____

8" @ 93

drlg. 3100

RECORD

Cased _____ in., _____ ft.

Sand _____

Gas _____

Oil _____

Total Depth _____

PRODUCTION

1st 24 hrs. Nat. _____

1st 24 hrs. after shot _____

Gas _____ Cu. Ft.

Dry Hole _____

Abandoned _____

Date

NOV 17 1948

19

S. J. LEWIS Scout

Kansas

Wherry Pool

Map No. 49 Sec. 10 Twp. 21 R. 7WWell No. 1 Deweese

Petroleum Inc.

Company

ABANDONED

Contractor

NW/C

E11610
SECTION PLAT330 Ft. from N. Line Ft. from S. Line Ft. from E. Line330 Ft. from W. Line

0			

Rice County

Location

Rig up

Drilling and Remarks:

Cong 3407

RECORD

Cased in., ft.Sand Gas Oil Total Depth 3430

PRODUCTION

1st 24 hrs. Nat. 1st 24 hrs. after shot Gas Cu. Ft.Dry Hole Abandoned

Date

NOV 23 1948

19

S. J. LEWIS - Scout