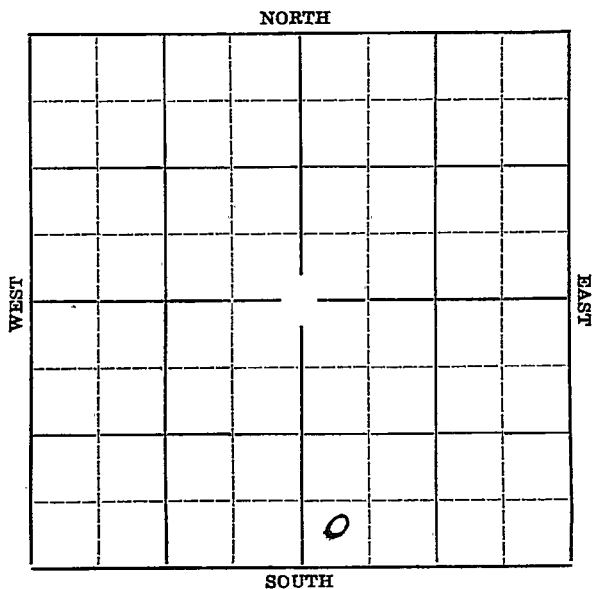


Section 10 Township 21 Range 7-NWell Number 1-HauschildCompany Garden Bros.

MPG
KANSAS

Map No. _____ Sec. 10 Twp. 21 R. 7W

Well No. #1 Hanschild Farm

Garden Brothers. Company

NORTH

Ft. from N. Line

330' Ft. from S. Line

Ft. from E. Line

330 Ft. from W. Line

Elev. 1607

SOUTH

West

EAST

Date _____

1936

REPORT

5/6 Cellar.

5/14 Rig.

5/21--5/28--

6/4 Rigging up.

6/11 Drlg. 1201.

7/1/36-Chat 3368'

T.D. 33851

6,912 bbls of oil. (Potential)

COMPLETED

KANSASMap No. 49 Sec. 10 Twp. 21 R. 2WWell No. 1 HauschildGarden Bros. Company

Contractor

SECTION PLAT

Ft. from N. Line

330 Ft. from S. Line

Ft. from E. Line

330 Ft. from W. Line**FIRST REPORT**

Location

Rig up

Drilling and Remarks:

Cellar**RECORD**

Cased in., ft.

Sand

Gas

Oil

Total Depth

PRODUCTION

1st 24 hrs. Nat.

1st 24 hrs. after shot

Gas Cu. Ft.

Dry Hole

Abandoned

Date

MAY 6 1936

192

S. J. LEWIS Scout

KANSAS

Map No. 49 Sec. 10 Twp. 21 R. 7WWell No. 1 HausschildGarcken Bros Company

Contractor

SECTION PLAT

 Ft. from N. Line330 Ft. from S. Line Ft. from E. Line330 Ft. from W. Line

COMPLETED

Location Rig up

Drilling and Remarks:

Chas 3368.Pr 69/28 1/2.

RECORD

Cased in., ft.Sand Gas Oil Total Depth 3375

PRODUCTION

1st 24 hrs. Nat. 1st 24 hrs. after shot Gas Cu. Ft.Dry Hole Abandoned

Date

JUL 1 1936 ₁₉

S. J. LEWIS Scout