


Rice

Section 10 Township 21 Range 7-W

Well No. 3 Hauschild

Company Mid-Plains

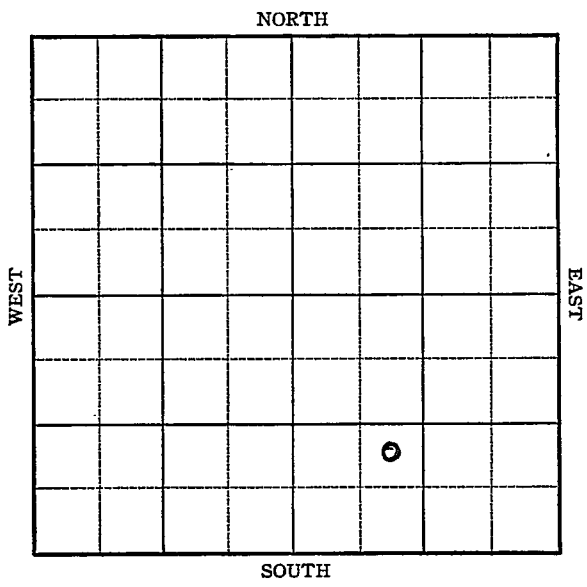


KANSAS

Rice

Sec. 10 Twp. 21 R. 7-WWell No. #3 Hauschild FarmMid-Plains Company Ft. from N. Line990 Ft. from S. Line Ft. from E. Line990 Ft. from W. Line

Elev. 1606

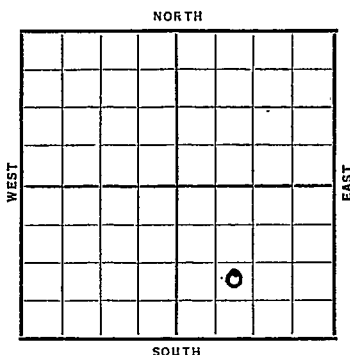

Date

REPORT

1937

12/8

R U R

12/17

10" @ 102'. Drlg. 420'.

12/24

Drlg. 2545'.

12/31

Cong. 3367 & 7". WOG.

No shows reported.

1938

1/7

T.D. 3379'. Rng. tubing.

1/12

7" @ 3369'.

Cong. 3369'.

T.D. 3379'.

Potential 631 bbls. with sm.

S. W.

COMPLETED

Rice

KANSAS

Map No. _____ Sec. 10 Twp. 21 R. 7WWell No. 3 Hauschild _____

_____ Mid-Plains _____ Company

FIRST REPORT _____ Contractor

NE SW SE

_____ Ft. from N. Line

990 _____ Ft. from S. Line

_____ Ft. from E. Line

990 _____ Ft. from W. Line

SECTION PLAT

		0	

Location _____

Rig up _____

Drilling and Remarks:

RUR

RECORD

Cased _____ in., _____ ft.

Sand _____

Gas _____

Oil _____

Total Depth _____

PRODUCTION

1st 24 hrs. Nat. _____

1st 24 hrs. after shot _____

Gas _____ Cu. Ft.

Dry Hole _____

Abandoned _____

Date

DEC 8 - 1937 19

H. D. Hatfield Scout

Rice

KANSAS

Map No. 49 Sec. 10 Twp. 21 R. 7WWell No. 3 HauschildMid-Plains

Company

Contractor

COMPLETED

SECTION PLAT

NE SW SE

 Ft. from N. Line990 Ft. from S. Line Ft. from E. Line990 Ft. from W. Line

		0	

Location Rig up

Drilling and Remarks:

POT-631
with sm. S.W.

RECORD

Cased 7 in., 3369 ft.~~Sand~~ *Cong* 3369Gas Oil Total Depth 3379

PRODUCTION

1st 24 hrs. Nat. 1st 24 hrs. after shot Gas Cu. Ft.Dry Hole Abandoned

Date

JAN 12 1938

19

H. D. Hatfield Scout