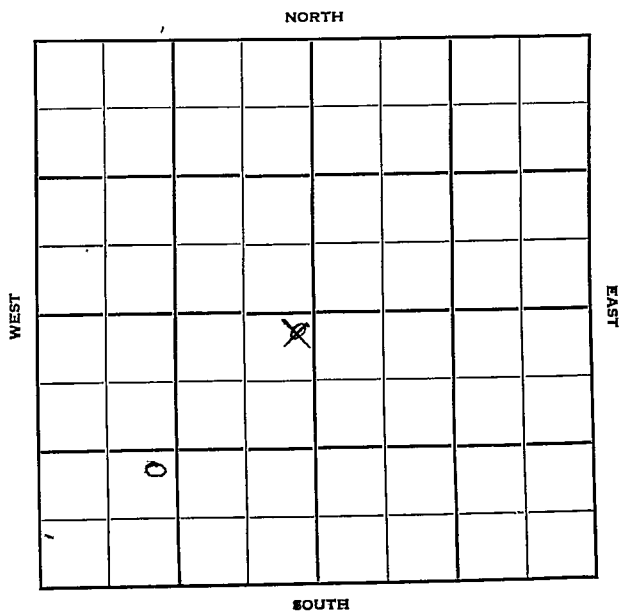


Section 10 Township 21 Range 7-WWell No. #1 JohnsonCompany Reno Pet. Co.

Rice
21

KANSAS

7W

Sec. 10 Twp. 21 R. 7W

Well No. #1 Johnson Farm

Reno Pet. Co.

Company

Murfin Drlg.

Contractor

100' Ft. from N. Line


1220' Ft. from S. Line

100' Ft. from E. Line

1220' Ft. from W. Line

NE SW

NE SW SW

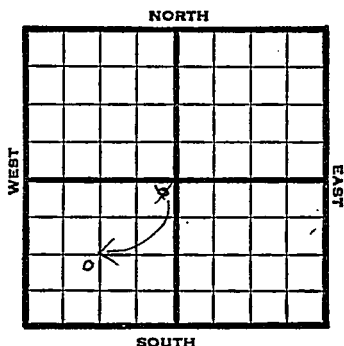

1950 Elev. 1610' REPORT

4/5 Spud 3-29-50
8-5/8" @ 162'
Drlg. 2296'
6/28 8 5/8" @ 162
Heeb 2690
Cong 3364
5 1/2" @ 3364
1 boph 3364-89
TD 3436 no inc.
PB 3389
30 qt 3364-89
D&A

Lans 2880


ABANDONED

Kansas

Map No. _____ Sec. 10 Twp. 21 R. 7WWell No. 1 Johnson_____Reno Pet. Co._____
Company_____Murfin Drlg._____
Contractor

NE SW

SECTION PLAT

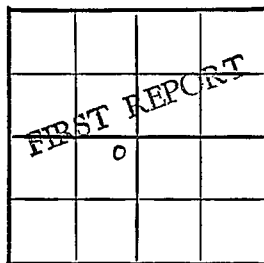100 Ft. from N. Line_____
Ft. from S. Line100 Ft. from E. Line_____
Ft. from W. LineRice County

Location _____

Rig up _____

Drilling and Remarks: *✓*

Spud 3-29-50

8 5/8" @ 162

drlg. 2296

RECORD

Cased _____ in., _____ ft.

Sand _____

Gas _____

Oil _____

Total Depth _____

PRODUCTION

1st 24 hrs. Nat. _____

1st 24 hrs. after shot _____

Gas _____ Cu. Ft.

Dry Hole _____

Abandoned _____

Date

APR 5 1950 19J. E. TYRA
Scout

Kansas

Map No. _____ Sec. 10 Twp. 21 R. 7W

Well No. 1 Johnson

Reno Petroleum Company

CORRECTION

Contractor

NE SW SW

E. 1610

SECTION PLAT

_____ Ft. from N. Line

1220 Ft. from S. Line

_____ Ft. from E. Line

1220 Ft. from W. Line

0			

Rice County

Location _____

Rig up _____

Drilling and Remarks:

Reported

NE SW

RECORD

Cased _____ in., _____ ft.

Sand _____

Gas _____

Oil _____

Total Depth _____

PRODUCTION

1st 24 hrs. Nat. _____

1st 24 hrs. after shot _____

Gas _____ Cu. Ft.

Dry Hole _____

Abandoned _____

Date

APR 26 1950

19

J. E. TYRA

Scout

Kansas

Map No. _____ Sec. 10 Twp. 21 R. 7WWell No. 1 Johnson

_____ Reno Pet. Co. _____ Company

_____ Contractor


NE SW SW

El. 1610
SECTION PLAT

_____ Ft. from N. Line

1220 Ft. from S. Line

_____ Ft. from E. Line

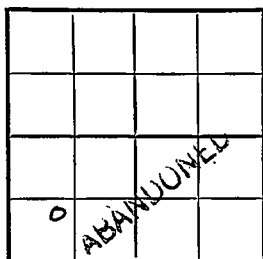1220 Ft. from W. Line

Rice County

Location _____

Rig up _____

Drilling and Remarks:

8 5/8" @ 162

Heeb. 2690

Lans. 2880

Cong. 3364

5 1/2" @ 3364

1 boph 3364-89

TD 3436 no inc.

RECORD

Cased _____ in., _____ ft.

Sand _____

Gas _____

Oil _____

Total Depth 3436

PRODUCTION

1st 24 hrs. Nat. _____

1st 24 hrs. after shot _____

Gas _____ Cu. Ft.

Dry Hole _____

Abandoned _____

Date

JUN 28 1950

19

J. E. TYRA

Scout

7 6 6

UNIT NO. _____

NAME OF UNIT _____

DATE _____

BY _____

UNIT NO.

UNIT NO.

3 1950

Scout Cards	76
Land Small Map	
Land Wall Map	
Tracings	
France Map	
Pierce Map	
Misc.	

D & A

Date 30 48 • 3364-89

PB 3389

10 2 8 100

10