
Rice

Form 51—5M—11-31—Palace

Map No. KANSAS Sec. 10 Twp. 21 R. 7W

Well No. 1 McCracken Farm

Garden et al Company

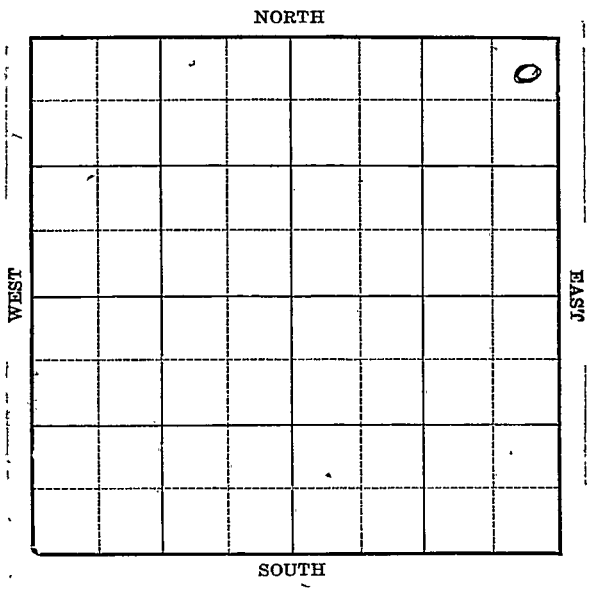

Location

Drilling Remarks

Rig Up

Drilling Remarks

RECORD

Cased ____ in. ____ ft.

Sand

Gas

Oil

Total Depth

PRODUCTION

1st 24 hrs. Nat.

1st 24 hrs. after shot

Gas ____ cu. ft.

Dry Hole

Abandoned

Rice

Form 252-A
5M 4-32 MPC

Map No. KANSAS Sec. 10 Twp. 21 R. 9W

Well No. 1 Mc Cracken Farm


Garden et al Company

330 Ft. from N. Line

Ft. from S. Line

330 Ft. from E. Line

Ft. from W. Line

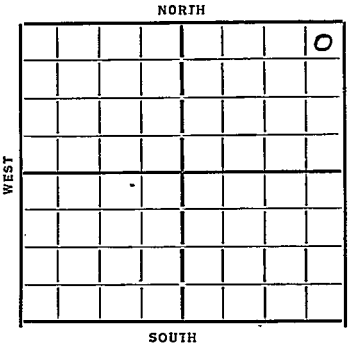

Date 1934	REPORT
3/21	Location
3/29	Cellar
4/5	Rig
4/12	—
4/19	Rig up
4/26	—
5/3	Spud
5/10	Dlg 1025 15½ 485
5/18	" 1560
5/25	" 2380 13" 1662
5/31	" 2839
6/7	— 6/14 —
6/21	Dlg 3175 8" 3111
6/28	" 3323 8" 3157
7/5	6" 3361 TC 3358
7/11	Chat 3358 TD 3361
	flow 862 Bbls.
	COMPLETED

Form 26—1M Bks.—9-28

KANSAS

Map No. 29 Sec. 10 Twp. 21 R. 7W

Well No. 1-McCracken

Garden etal Company

Contractor

FIRST REPORTS


330 Ft. from N. Line

Ft. from S. Line

330 Ft. from E. Line

Ft. from W. Line

SECTION PLAT

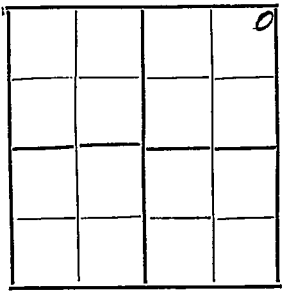

Location V

Rig up

Drilling and Remarks:

RECORD

Cased in., ft.

Sand

Gas

Oil

Total Depth

PRODUCTION

1st 24 hrs. Nat.

1st 24 hrs. after shot

Gas Cu. Ft.

Dry Hole

Abandoned

Date

3/21/37 192 O. Marmichael Scout

Form 26—1M Bks.—2-29

Pure

Map No. 49 Sec. 10 Twp. 21 R. 7W

Well No. 1-McCracken

Garden etal Company

Contractor

COMPLETED


330 Ft. from N. Line

_____ Ft. from S. Line

330 Ft. from E. Line

_____ Ft. from W. Line

SECTION PLAT

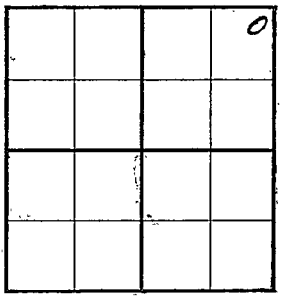

Location _____

Rig up _____

Drilling and Remarks:

flow
860 bbls

RECORD

Cased ____ in., ____ ft.

Sand- Chat 3358

Gas _____

Oil _____

Total Depth 3361

PRODUCTION

1st 24 hrs. Nat. _____

1st 24 hrs. after shot _____

Gas _____ Cu. Ft.

Dry Hole _____

Abandoned _____

Date

7-11-34 19 _____ Scout