

Rice


KANSAS

FORM 51 5M 2-38 TPCO.

Section 10 Township 21 Range 7-W

Well No. 1 Whinery


Company Mid-Plains

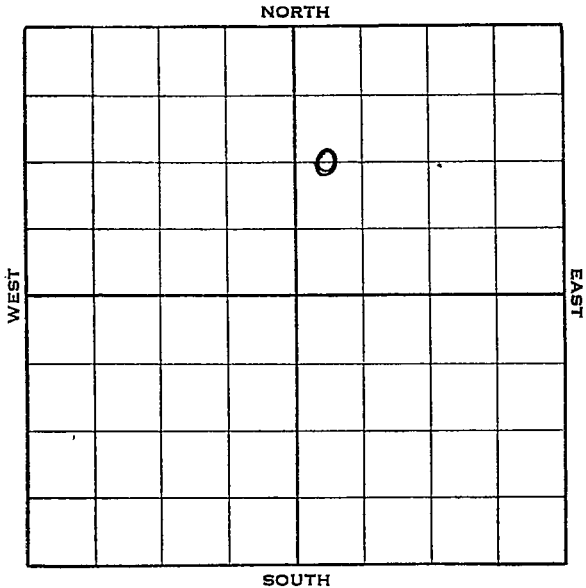

Well No. #1 Whinery Farm
Mid-Plains Company

330 Ft. from W. Line

Elev. 1608

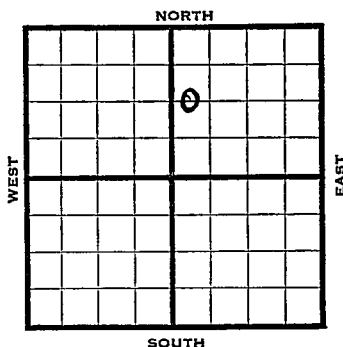

SOUTH

[illegible]

Rice KANSAS

Map No. 49 Sec. 10 Twp. 21 R. 7WWell No. 1 WhineryMid-Plains Company

Contractor

FIRST REPORT

C W L NE

1320 Ft. from N. Line Ft. from S. Line Ft. from E. Line330 Ft. from W. Line

SECTION PLAT

		0	

Location XRig up

Drilling and Remarks:

RECORD

Cased in., ft.Sand Gas Oil Total Depth

PRODUCTION

1st 24 hrs. Nat. 1st 24 hrs. after shot Gas Cu. Ft.Dry Hole Abandoned

Date

APR 6 - 1938

19

H. D. Hatfield Scout

Rice

KANSAS

Map No. 49 Sec. 10 Twp. 21 R. 7WWell No. 1 WhineryMid-Plains

Company

Contractor

COMPLETED

C W L NE

1320 Ft. from N. Line

_____ Ft. from S. Line

_____ Ft. from E. Line

330 Ft. from W. Line

SECTION PLAT

		0	

Location _____

Rig up _____

Drilling and Remarks:

POT 741

RECORD

Cased 7 in., 3364 ft.Sand CONG 3.36.3

Gas _____

Oil _____

Total Depth 3377

PRODUCTION

1st 24 hrs. Nat. _____

1st 24 hrs. after shot _____

Gas _____ Cu. Ft.

Dry Hole _____

Abandoned _____

Date

JUN 1 - 1938

19

F. D. Hatfield Scout