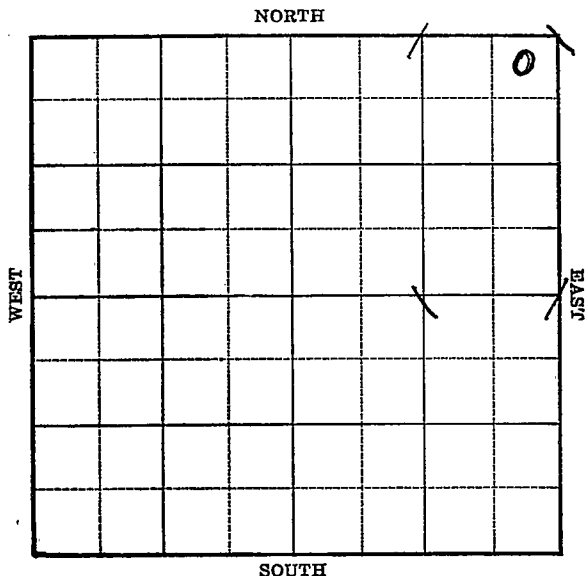


Section 10 Township 21 Range 9-WWell No. 1 WernerCompany Jock Garden Prod.

Rice

KANSAS

Map No. 49 Sec. 10 Twp. 21 R. 9WWell No. 1 WernerJock Garden Prod. Company

Contractor

FIRST REPORT

SECTION PLAT

330 ^{NE/C} Ft. from N. Line Ft. from S. Line330 Ft. from E. Line Ft. from W. Line

			0

Location Rig up

Drilling and Remarks:

12" - 77Dril g. 1550

RECORD

Cased in., ft.Sand Gas Oil Total Depth

PRODUCTION

1st 24 hrs. Nat. 1st 24 hrs. after shot Gas Cu. Ft.Dry Hole Abandoned

Date

NOV 30 193819H. D. Hatfield Scout

Rice **KANSAS**Map No. 49 Sec. 10 Twp. 21 R. 9WWell No. 1 **Werner****Jock Garden Prod.**

Company

Contractor

ABANDONED**NE/C**330 Ft. from N. Line Ft. from S. Line330 Ft. from E. Line Ft. from W. Line**SECTION PLAT**

			O

Location Rig up

Drilling and Remarks:

*B.K.C. 3224**cong 3260**Viola 3300**Simp. sd. 3345**S.O. 3355-614 63-78**Arb 3424**T.D. 3443**Ne oil**D & A*

Date

RECORDCased in., ft.Sand Gas Oil Total Depth **PRODUCTION**1st 24 hrs. Nat. 1st 24 hrs. after shot Gas Cu. Ft.Dry Hole Abandoned **DEC 13 1938** 19**E. D. Hatfield** Scout