


Section 10 Township 21 Range 11W
Well No. #3 Sifers "B"
Company Cities Service

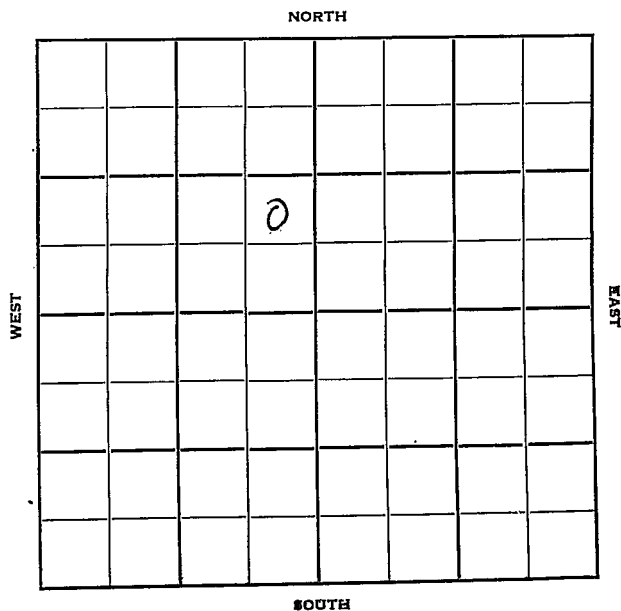

Stafford

KANSAS
11 W

Sec. 10 Twp. 21 R. 11 W

Well No. # 3 Sifers "B" Farm

Cities Service

Company

Contractor

Snider Pool


Ft. from N. Line

890 Ft. from S. Line

330 Ft. from E. Line

Ft. from W. Line

NE SE NW

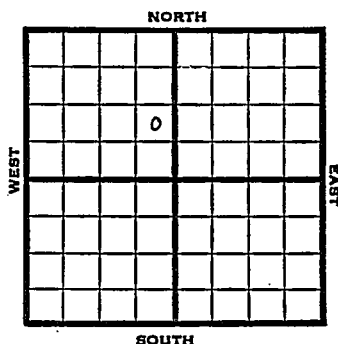

1951

Elev. 1762' REPORT

10/3

Location

11/7

Spud 10-16-51

D&A TD 3370

8" @ 319

Doug. sd 3019 Lans. 3074

DST 3150-62 opn $\frac{1}{2}$ hr Rec. 30' mud


& wtr Simp 3325 Arb. 3340

TD 3370

D&A

ABANDONED

County Stafford State Kansas
 Sec. 10 (Blk. 21) (Sur. 11W) (Rge.) Map No.
 Operator Cities Service
 Well No. 3 Farm Sifers "B"
 Elev. 1762 Location NE SE NW

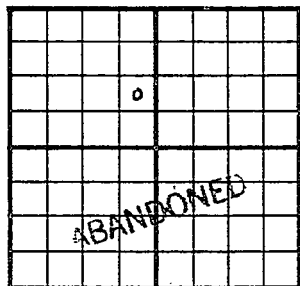

890 Ft. From S Line NW

330 Ft. From E Line Quarter

1st. Report

Completion NOV 7 1951

Remarks Snider Pool

Spudding Date 10-16-51

Drlg. Data D & A TD 3370

8" @ 319 Doug. sd. 3019 Lans. 3074

DST 3150-62 open $\frac{1}{2}$ hr. Rec. 30' mud &

water Simp. 3325 Arb. 3340 TD 3370

D & A

J. E. TYRA