


Section 10 Township 21 Range 11-W

Well Number 1 - Seifers "B"

Company Empire

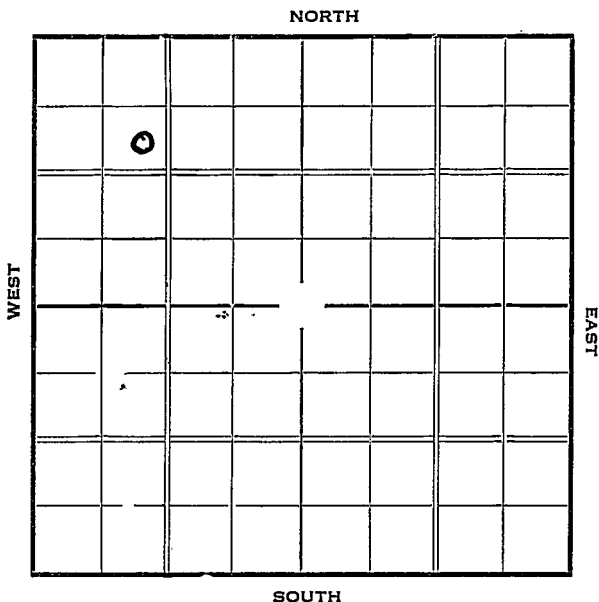

1937

7/30 Sil. 3330'. 5" @ 3331'.
T.D. 3334'. 2500' oil.
Testing.

8/4 5" @ 3331'.

Sil. 3330'.

T.D. 3337'.

1000 acid.

Pot. 437 bbls. 24 hrs.

COMPLETED

KANSAS

Map No. 46 Sec. 10 Twp. 21 R. 11 WWell No. 1-Seifers "B"Empire Company

Contractor

FIRST REPORT

SECTION PLAT

0			

1270 Ft. from N. Line

_____ Ft. from S. Line

_____ Ft. from E. Line

1249 Ft. from W. Line

Location _____

Rig up _____

Drilling and Remarks:

cellar

RECORD

Cased _____ in., _____ ft.

Sand _____

Gas _____

Oil _____

Total Depth _____

PRODUCTION

1st 24 hrs. Nat. _____

1st 24 hrs. after shot _____

Gas _____ Cu. Ft.

Dry Hole _____

Abandoned _____

Date

APR 28 1937 19

H. D. Hatfield Scout

Map No. _____ Sec. 10 Twp. 21 R. 11 WWell No. 1 - Siefers "B"Empire Company

Contractor

COMPLETE

SECTION PLAT

1270 Ft. from N. Line

_____ Ft. from S. Line

_____ Ft. from E. Line

1249 Ft. from W. Line

0			

Location _____

Rig up _____

Drilling and Remarks:

1000 AcidRot - 437/24

RECORD

Cased 5 in., 3331 ft.Sand 511 3330

Gas _____

Oil _____

Total Depth 3337

PRODUCTION

1st 24 hrs. Nat. _____

1st 24 hrs. after shot _____

Gas _____ Cu. Ft.

Dry Hole _____

Abandoned _____

Date

AUG 4 - 1937 19H. D. Hatfield Scout