


Section 10 Township 21 Range 12W

Well No. #1 Christiansen "B"

Company Dizard Investment Co.

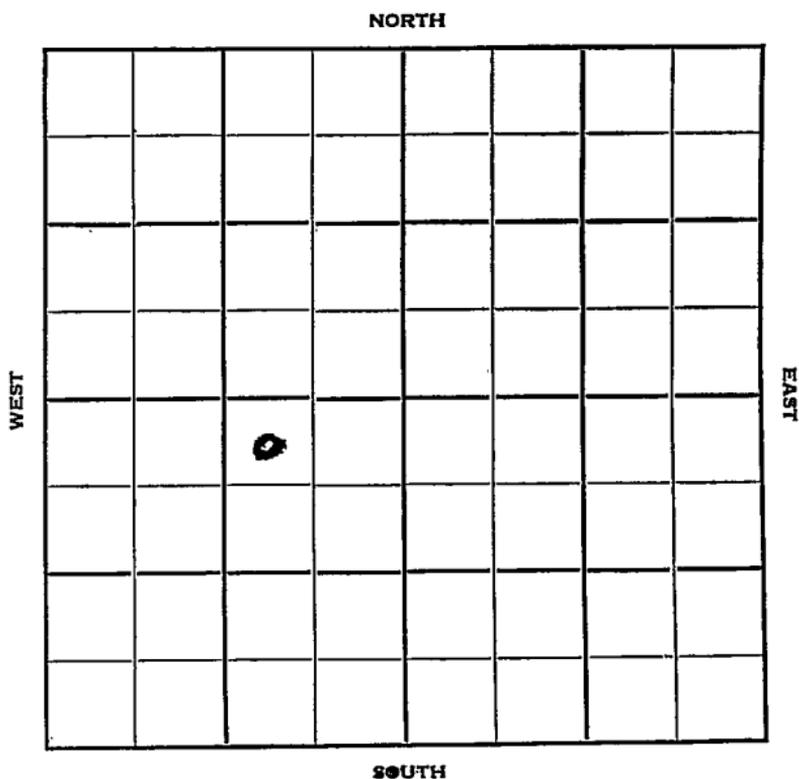

Sec. 10 Twp. 21 R. 12W

Well No. #1 Christiansen "B" Farm

Dizdar Investment Co. Company

Duke & Wood - Contr. Contractor


330' Ft. from N. Line

_____ Ft. from S. Line

990' Ft. from E. Line

_____ Ft. from W. Line

NW NE SW

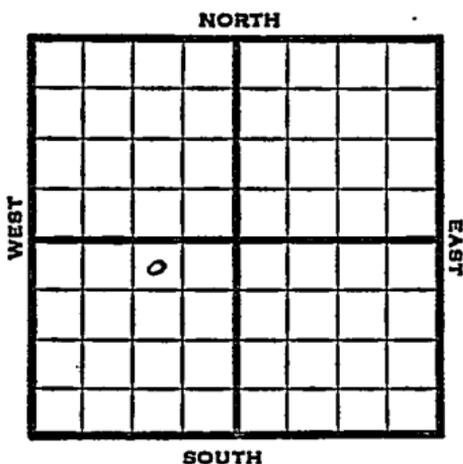

1951 Elev. 1847' REPORT

6/6 Spud 5-29-51
8" @ 227
Anhy 624

6/13 Drlg. 2460'
Spud 5-29-51
D&A TD 3601
8" @ 227
Anhy 624' Heeb. 3099
Br Lime 3234 Lans. 3248
Cong. 3470' Arb. 3539
DST 3540-52 opn 1 hr Rec. 137' sw
TD 3601' D&A

ABANDONED

County Stafford State KANSAS

Sec. 10 (Blk. Twp.) 21 (Sur. Rge.) 12W Map No.

Operator Dizdar Investment Co.

Well No. 1 Farm Christiansen "B"

Elev. _____ Location NW NE SW

FIRST REPORT

0

330 Ft. From N Line SW

990 Ft. From N Line Quarter

Ist. Report JUN 6 1951

Completion _____

Remarks _____

Duke & Wood - Contr.

Spudding Date 5-29-51

Drlg. Data _____

8" @ 227 Anhy 624 drlg. 2460

J. E. TYRA


County Stafford State Kansas

Sec. 10 (Blk. 21 (Sur. 12W Map No. 21 (Rge. 12W Map No. 21)

Operator Dizard Investment Co.

Well No. 1 Farm Christiansen "B"

Elev. 1847 Location NW NE SW

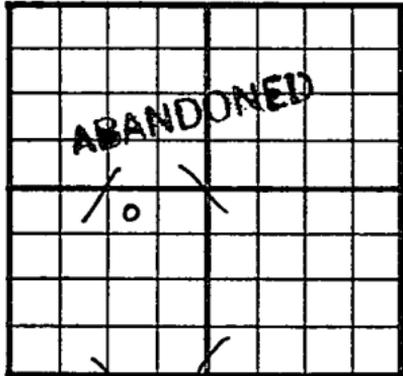

330 Ft. From N Line SW

990 Ft. From E Line Quarter

Ist. Report

Completion JUN 13 1951

Remarks

Duke & Wood - Contr.

Spudding Date 5-29-51

Drlg. Data D & A TD 3601

8" @ 227 Anhy 624 Heeb. 3099

Br. lime 3234 Lans. 3248

Cong. 3470 Arb. 3539 DST 3540-

52 open 1. hr. - Rec. 137' sw

TD 3601 D & A