

Stafford

KANSAS 2W

Section 10 Township 21 Range

Well No. #1 Christiansen

Company Duke & Wood et al

NORTH

WEST

0							

EAST

SOUTH

Sec. 10 Twp. 21 R. 12W

Well No. #1 Christiansen Farm

Duke & Wood et al Company

Duke & Wood Contractor


 Ft. from N. Line

990' Ft. from S. Line

 Ft. from E. Line

330' Ft. from W. Line

NW SW NW

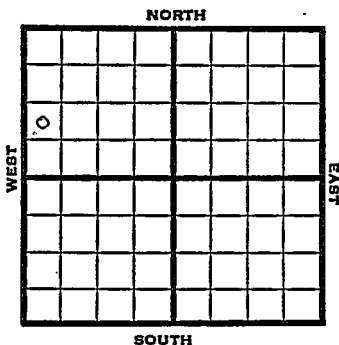

1951 Elev. 1843' REPORT

5/2 Spud 4-30-51
8" @ 231
WOC

6/27 Spud 4-30-51 Oil well TD 3506'
8" @ 231 Anhy 624-44
DST 3500-06 open 24 min. rec 92' oil
Arb. 3502-06' 5" @ 3503 TD 3506
S/3 BOPH 500 A 6 BOPH
Comp. 42 BOPD

COMPLETED

County Stafford State KansasSec. 10 (Blk. Twp.) 21 (Sur. Rge.) 12W Map No.Operator Duke & Wood et al.Well No. 1 Farm ChristiansenElev. Location NW SW NW

0

FIRST REPORT

990 Ft. From S Line NW330 Ft. From W Line Quarter1st. Report MAY 2 1951

Completion


Remarks

Duke & Wood - Contr.Spudding Date 4-30-51

Drlg. Data

8" @ 231 WOC

J. E. TYRA

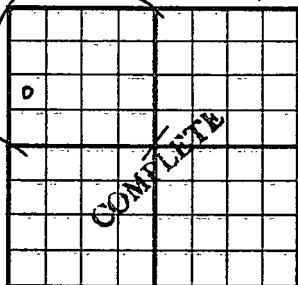County Stafford State KansasSec. 10 (Blk.
Twp.) 21 (Sur.
Rge.) 12W Map No.Operator Duke & Wood etal.Well No. 1 Farm ChristiansenElev. 1843 Location NW SW NW990 Ft. From S Line NW330 Ft. From W Line Quarter1st. ReportCompletion JUN 27 1951RemarksDuke & Wood - Contr.Spudding Date 4-30-51Drlg. Data Oil well TD 35068" @ 231 Anhy 624-44 DST 3500-06open 25 min. Rec. 92' oil Arb. 3502-065" @3503 TD 3506 S/ 3 boph 500 A6 boph Comp. 42 bopd

J. E. TYRA