

Pawnee


KANSAS

SECTION 10 TOWNSHIP 21 RANGE 18W

WELL NO. #1 Brown

COMPANY Anschutz etal

NORTH

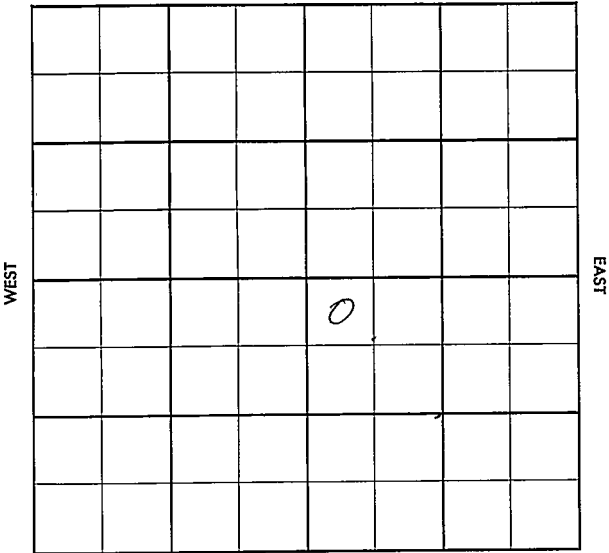

SOUTH

Pawnee

KANSAS

SEC.	TWP.	R.
10	21	18 W

WELL NO.

1 Brown

FARM

COMPANY

Anschutz et al

CONTRACTOR

Kan-Tex


Wil deat

_____ Ft. from N. Line

_____ Ft. from S. Line

_____ Ft. from E. Line

_____ Ft. from W. Line

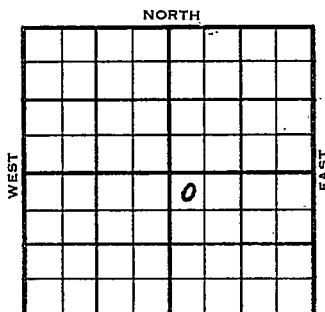

NW NW SE

(Kan-Tex int.) Gulf DHM; A-P- BHM;^{OUTH}

R. Rerguson FO SDX Lse- 5/8 Mile

ELEVATION

REPORT

1956

2090

Arb. Test

4/4

Comm. 3-28-56

8" @ 227/200

Drlg. 2755'

4-11

DST 3755-3825 op 45 min. rec. 30' vsocm
90' mud, 90' sw, 1240#DST 3970-85 op 1 hr. rec. 15' mud, 0#
D & A

H. 3486

Tr. 3504

L. 3576

C. Sd. 3978

G. Wh. 4000

Granite 4023

TD 4026

ABANDONED

County Pawnee Elev. _____
 Sec. 10 Twp. 21 Rge. 18W
 Company Anschutz et al.
 Farm Name Brown No. 1

TOPS	DEPTH	LOG	DATUM	Loc. in Sec.
Anh.				NW NW SE
Tr.				
H.				
Tr.				
Dg.				Arb. test
BL.				
L.				Geol.
K.C.				Contr.
B.K.C.				Kan-Tex
Ce.				
C.				Pool
M.				Wildcat
M.				
K.				
Mz.				
Mo.				
V.				
S.				
S.				
A.				
R.				
PE.				
G.				
ED.				

5/11/14
 FIRST REPORT
 APR 4 '50

Date Comm. 3-28-56

Kan-Tex (int.) Gulf-DHM A-P BHM

R. Ferguson FO

8" @ 227/200 drlg. 2755

County Pawnee Elev. 2090
 Sec. 10 Twp. 21 Rge. 18W
 Company Anschutz et al.
 Farm Name Brown No. 1

TOPS	DEPTH	LOG	DATUM	Loc. in Sec.
Anh.				NW NW SE
Tr.				
H.	<u>3486</u>			
Tr.	<u>3504</u>			
Dg.				
Bl.				
L.	<u>3576</u>		<u>1486</u>	Geol.
K.C.				Contr.
B.K.C.				
Ce.				
C. <u>sd</u>	<u>3978</u>		<u>1888</u>	Kan-Tex
M.				
M.				Pool
K.				Wildcat
Mz.				
Mq.				
V.				
S.				
S.				
A.				
R.				
PE.				
G. <u>wh</u>	<u>4000</u>		<u>1910</u>	
<u>Granite</u>	<u>4023</u>		<u>1933</u>	
T.D.	<u>4026</u>			

ABANDONED

Date Comm. 3-28-56 APR 1 1 1956

8" @ 227/200 DST 3755-3825 open 45 min.

rec. 30' vsocm 90' mud 90' sw

12h0# DST 3970-85 open 1 hr. rec.

15' mud 0#

D & A