


Section 11 Township 21 Range 13 ^{KANSAS} _W

Well No. #1 Allphin

Company Cliff McGown

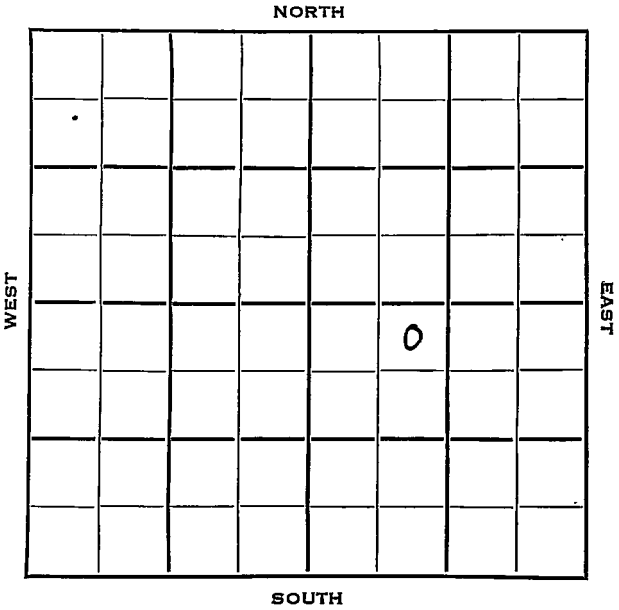

Stafford

KANSAS ✓

Sec. 11 Twp. 21 R. 13S

Well No. #1 Allphin Farm

Cliff McCown Company

Edwards Contractor

Rothgarn Pool


330 Ft. from N. Line

_____ Ft. from S. Line

_____ Ft. from E. Line

990 Ft. from W. Line

NE NW SE

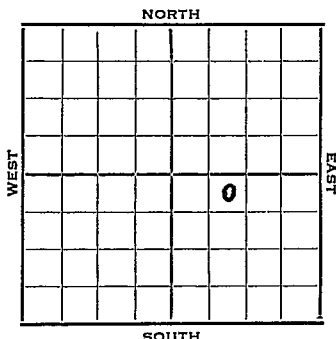

1953 Elv. 1866'

REPORT

7/11 MIRT

7/22 8" @ 288 w/235
Drlg.

7/29 Drlg. 2956'

8/5 Spud 7-18-53
D & A

TD 3564'

8" @ 288'

Heeb 3130, Br. Lime 3261, Lans 3280

B KC 3489, Cong 3517, Arb 3549


TD 3564'

D & A

ABANDONED

J. G. McGEHEE

County Stafford State Kansas
 Sec. 11 (Blk.) 21 (Sur.) 13W Map No.
 Operator Cliff McCown
 Well No. 1 Farm Allphin
 Elev. 1866 Location NE NW SE

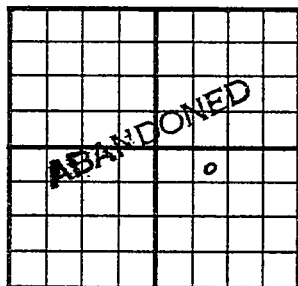

330Ft. From N Line SE
990Ft. From W Line Quarter

1st. Report

Completion AUG 5 1953

Remarks Rothgarn Pool

Edwards - Contr.

Spudding Date 7-18-53

Drlg. Data D & A TD 3564

8" @ 288 Heeb. 3130 Br. lime 3261

Lans. 3280 B KC 3489 Cong. 3517

Arb. 3549 TD 3564

D & A