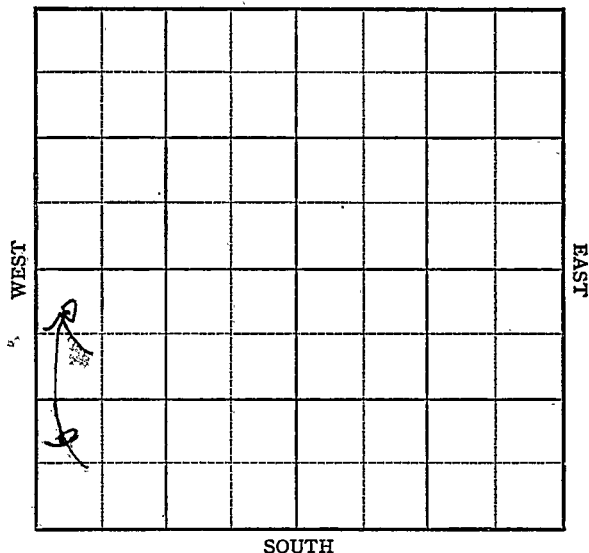


KANSAS

Stafford

Section 11 Township 21 Range 13WWell No. 2 McDonaldCompany AtlanticRothgarn
NORTH

KANSAS Stafford

Sec. 11 Twp. 21 R. 13W

Well No. #2 McDonald Farm

Atlantic Company


Rothgarn Pool

330 Ft. from N. Line

~~880~~ Ft. from S. Line

_____ Ft. from E. Line

330 Ft. from W. Line

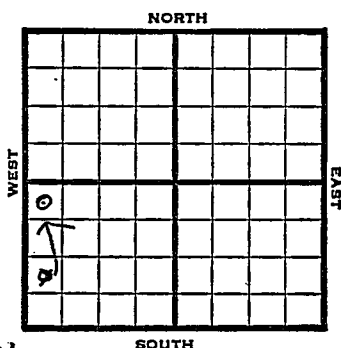

~~NW SW SW~~ *new 8w*

1949 Elev 1873' REPORT

3/9 Location

3/16 8" @ 267'

Drlg. 1804'

3/28 Lansing 3266'

Drlg 3316'

3/30 Simpson 3498'

Arbuckle 3512'

TD 3517'

5" @ 3513'

4/6 TD 3517'

700' oil - 14 hrs.

4/12 "

4/20 TD 3518'

1500 acid

Swb 22 bbls oil PH 4 hrs.

4/27 TD 3518'

Arb. 3512'

5" @ 3513'

1500 acid

Pump 413 Oil Pot

39° Gr.

Comp

COMPLETED

Map No. _____ Sec. 11 Twp. 21 R. 13W

Well No. 2 McDonald

Atlantic Company

FIRST REPORT Contractor

NW SW SW

SECTION PLAT

_____ Ft. from N. Line

990 Ft. from S. Line

_____ Ft. from E. Line

330 Ft. from W. Line

6			

Stafford County

Location X

Rig up _____

Drilling and Remarks:

RECORD

Cased _____ in., _____ ft.

Sand _____

Gas _____

Oil _____

Total Depth _____

PRODUCTION

1st 24 hrs. Nat. _____

1st 24 hrs. after shot _____

Gas _____ Cu. Ft.

Dry Hole _____

Abandoned _____

Date

MAR 9 1949 19

S. J. LEWIS Scout

Map No. _____ Sec. 11 Twp. 21 R. 13W

Well No. 2 McDonald

Atlantic Company
CORRECTION

Contractor

NW SW

SECTION PLAT

330 Ft. from N. Line

_____ Ft. from S. Line

_____ Ft. from E. Line

330 Ft. from W. Line

o			

Stafford County

RECORD

Location _____

Cased _____ in., _____ ft.

Rig up _____

Sand _____

Drilling and Remarks:

Gas _____

Oil _____

Total Depth _____

Reported

NW SWSW

PRODUCTION

1st 24 hrs. Nat. _____

1st 24 hrs. after shot _____

Gas _____ Cu. Ft.

Dry Hole _____

Abandoned _____

Date

MAR 16 1949

19

S. J. LEWIS

Scout

Map No. 82 ^{Kansas} Sec. 11 Twp. 21 R. 13W

Well No. 2 McDonald

Atlantic Company

COMPLETE

Contractor

NW SW

E 1/8 23
SECTION PLAT

330 Ft. from N. Line

 Ft. from S. Line

 Ft. from E. Line

330 Ft. from W. Line

0			

Stafford County

Location

Rig up

Drilling and Remarks:

See 82512
5" casing
15000 cu ft
Pump 4 1/2 in. dia

392 lb

RECORD

Cased in., ft.

Sand

Gas

Oil

Total Depth 3518

PRODUCTION

1st 24 hrs. Nat.

1st 24 hrs. after shot

Gas Cu. Ft.

Dry Hole

Abandoned

Date

APR 27 1949 19

S. J. LEWIS

Scout